

# KANSAS


FORM 51 5M 10-41 PETROL

Barton

Section 33 Township 18 Range 15-W

Well No. #1 Bird

Company Nate Appleman et al

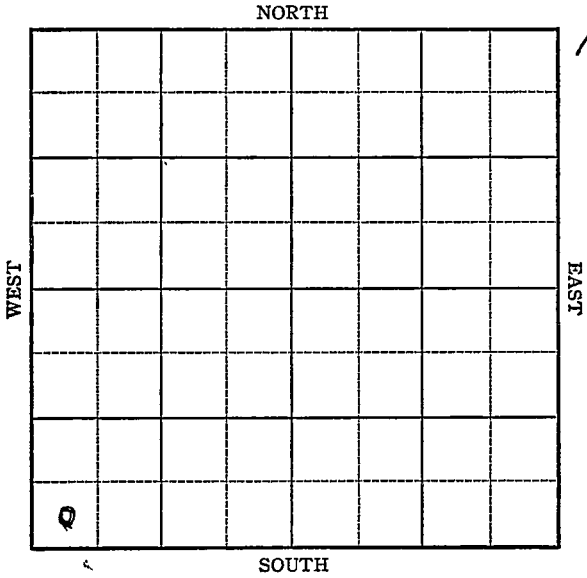

Sec. 33 Twp. 18 R. 15-W

Well No. #1 Bird Farm

Nate Appleman et al Company

(Wildcat)


\_\_\_\_\_ Ft. from N. Line

330 Ft. from S. Line

\_\_\_\_\_ Ft. from E. Line

330 Ft. from W. Line

*E 199 7 L.S.*

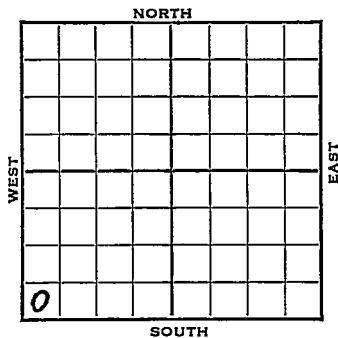

1942

REPORT

7/15 Cable rig.  
7/22 " "  
7/29 Drlg. 880'  
8/5 Anhy 970 10" - 975  
Drlg. 1275'  
8/12 Drlg 2260  
8/19 SS Gas 2375'  
Drlg. 2960'  
8/27 7" @ 3290 Lans 3290 Drlg 3314  
9/2 TD 352 Run 5"  
9/9 5" @ 3527 Reagan 3584  
TD 3623 3 M gas  
9/16 Drlg 3675  
9/23 Reagan 3588  
5" 3597  
TD 3680  
Water

**ABANDONED**

Map No. 73 Sec. 33 Twp. 18 R. 15WWell No. 1 BirdNate Appleman et al. Company**FIRST REPORT** Contractor

SW/C

## SECTION PLAT

\_\_\_\_\_ Ft. from N. Line

330 Ft. from S. Line

\_\_\_\_\_ Ft. from E. Line

330 Ft. from W. Line

o			

**WILDCAT**

Location \_\_\_\_\_

Rig up \_\_\_\_\_

Drilling and Remarks:

**Cable Rig**

## RECORD

Cased \_\_\_\_\_ in., \_\_\_\_\_ ft.

Sand \_\_\_\_\_

Gas \_\_\_\_\_

Oil \_\_\_\_\_

Total Depth \_\_\_\_\_

## PRODUCTION

1st 24 hrs. Nat. \_\_\_\_\_

1st 24 hrs. after shot \_\_\_\_\_

Gas \_\_\_\_\_ Cu. Ft.

Dry Hole \_\_\_\_\_

Abandoned \_\_\_\_\_

Date

JUL 15 1942 19S I LEWIS Scout

