


Section..... 33 ..... Township..... 18 ..... Range..... 15-W

Well Number..... 1 Bird .....

Company..... Schermerhorn .....

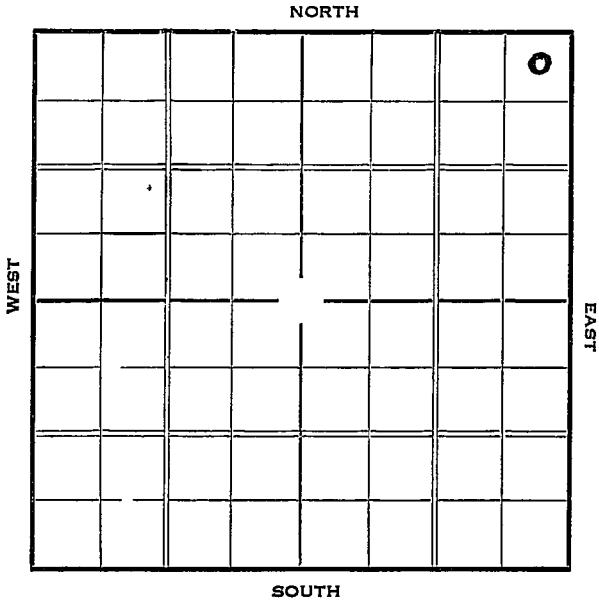

Sec. 33 Twp. 18 R. 15-W

Well No. #1 Bird Farm

Schermerhorn Company


330 Ft. from N. Line

         Ft. from S. Line

330 Ft. from E. Line

         Ft. from W. Line

Elev. 1909

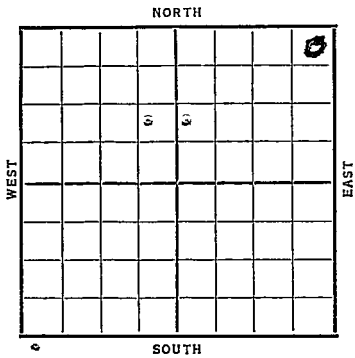

Date  
**1937**

**REPORT**

2/24

Location

3/4

Rig

3/11

"

3/18

Rigging up.

3/25

15" @ 313'. Drlg.

4/2

Drlg. 665'.

4/8

Drlg. 1620', 13" @ 888'

Anhydrage 870'

4/16

Drlg. 2310'.

4/23

Drlg. 2580'.

4/30

Fishg. 3160'.

5/7

Drlg. up bailer 3160'.

5/14

Pulling 8".

5/21

8" @ 3250'. Drlg. 3305'.

5/28

Sand 3482'. T.D. 3483'.

6/4

T.D. 3486'. 7" @ 3482'.

Est. 8 M gas. WOC.

**OVER**

6/11 36 M gas & spray oil @ 3533'.  
T.D. 3535' SW. P.B. 3533g.

6/16 7" @ 3482'.  
Regan 3482'.  
T.D. 3535' S.W.  
P.B. 3533'.  
36½ M gas.

**COMPLETED**

*Barton*

Map No. 73 Sec. 33 Twp. 18 R. 15W

Well No. 1 Bird

Schmerhorn Company

Contractor

### SECTION PLAT

			0

330 Ft. from N. Line

\_\_\_\_\_ Ft. from S. Line

330 Ft. from E. Line

\_\_\_\_\_ Ft. from W. Line

## FIRST REPORT

Location     

Rig up \_\_\_\_\_

Drilling and Remarks:

### RECORD

Cased \_\_\_\_\_ in., \_\_\_\_\_ ft.

Sand \_\_\_\_\_

Gas \_\_\_\_\_

Oil \_\_\_\_\_

Total Depth \_\_\_\_\_

### PRODUCTION

1st 24 hrs. Nat. \_\_\_\_\_

1st 24 hrs. after shot \_\_\_\_\_

Gas \_\_\_\_\_ Cu. Ft.

Dry Hole \_\_\_\_\_

Abandoned \_\_\_\_\_

Date

FEB 24 1937 19

S. J. LEWIS Scout

Barton **KANSAS**Map No. 73 Sec. 33 Twp. 18 R. 15<sup>w</sup>Well No. 1-BirdSchermerhorn Company

Contractor

**COMPLETED****SECTION PLAT**330 Ft. from N. Line

\_\_\_\_\_ Ft. from S. Line

330 Ft. from E. Line7 Ft. from W. Line

			0

Location \_\_\_\_\_

Rig up \_\_\_\_\_

Drilling and Remarks:

P.B. 353336 1/2 M. gas**RECORD**Cased 7 in., 3482 ft.Sand Regan 3482

Gas \_\_\_\_\_

Oil \_\_\_\_\_

Total Depth 3535 SW**PRODUCTION**

1st 24 hrs. Nat. \_\_\_\_\_

1st 24 hrs. after shot: \_\_\_\_\_

Gas \_\_\_\_\_ Cu. Ft.

Dry Hole \_\_\_\_\_

Abandoned \_\_\_\_\_

Date

JUN 16 1937 19H. D. Hatfield Scout