

Kansas

Map No. _____ Sec. 33 Twp. 27 R. 7

Well No. 1 Cary Farm
Becker E. & Co. Company

NORTH

WEST

EAST

SOUTH

Location _____

Drilling Remarks:

Rig Up-----

Drilling Remarks:

RECORD

Cased _____ in. _____ ft.

Sand _____

Gas _____

Oil _____

Total Depth -----

PRODUCTION

1st 24 hrs. Nat. -----

1st 24 hrs. after shot-----

Gas _____ cu. ft.

Dry Hole_____

Abandoned_ _ _ _ _

Map No. _____ Sec. 33 Twp. 27 R. 7


Well No. #1 Cleary Farm
Becker et al Company

_____ Ft. from N. Line

200 Ft. from S. Line

_____ Ft. from E. Line

200 Ft. from W. Line

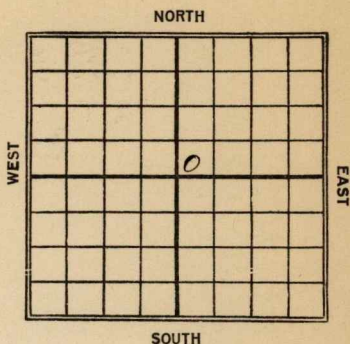

Date _____

REPORT

Date 1922

 $7\frac{1}{2} \text{ z}$

Pig up & SD

8/4

S. D. 560'

1924

4/24

S.D. 560'

7/16

- 560 S.D.

11/19

S.D. 560'

12/17

1925

1/21

3/30

abandoned 560

Map No. *Kans. 10 33* Sec. *27* Twp. *7* R. *7*Well No. *1 Clear**Becker et al* Company

Contractor

FIRST REPORT

SECTION PLAT

Ft. from N. Line

200 Ft. from S. Line

Ft. from E. Line

300 Ft. from W. Line

Location

Rig up

Drilling and Remarks:

Rig up & SD

RECORD

Cased _____ in., _____ ft.

Sand _____

Gas _____

Oil _____

Total Depth _____

PRODUCTION

1st 24 hrs. Nat. _____

1st 24 hrs. after shot _____

Gas _____ Cu. Ft.

Dry Hole _____

Abandoned _____

Date

JUL 22 1922

M. A. BENEAR

191

Scout

10 **KANSAS** Map No. _____ Sec. 33 Twp. 27 R. 7

Well No. 1 Cleary _____

Buckner et al. _____ Company

_____ Contractor

ABANDONED

SECTION PLAT

_____ Ft. from N. Line

200 Ft. from S. Line

_____ Ft. from E. Line

200 Ft. from W. Line

Location _____

Rig up _____

Drilling and Remarks:

RECORD

Cased _____ in., _____ ft.

Sand _____

Gas _____

Oil _____

Total Depth _____

PRODUCTION

1st 24 hrs. Nat. _____

1st 24 hrs. after shot _____

Gas _____ Cu. Ft.

Dry Hole _____

Abandoned 360' _____

Date

3/30 1925

M. A. BENEAR

Scout