


Map No. 15 Sec. 21 Twp. 30 R. 11 E
 Well No. 1 - Fleek Farm
York State oil Company

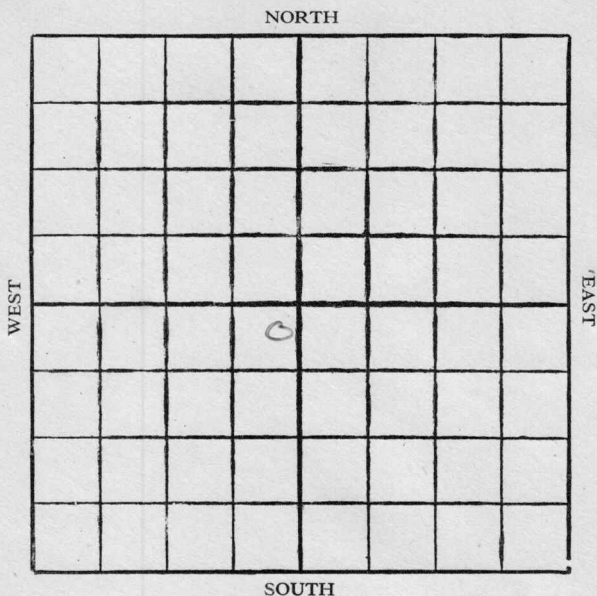

Location

Drilling Remarks

.....

.....

RECORD

Cased..... in. ft.

Sand

Gas

Oil

Total Depth.....

Rig Up.....

Drilling Remarks

.....

.....

PRODUCTION

1st 24 hrs. Nat.....

1st 24 hrs. after shot.....

Gas..... cu. ft.

Dry Hole.....

Abandoned.....

KANSAS

Map No. _____ Sec. 21 Twp. 30 R. 11Well No. 1 FluerYork State Oil Co Company

Contractor

FIRST REPORTS

200 Ft. from N. Line

Ft. from S. Line

200 Ft. from E. Line

Ft. from W. Line

COMPLETED

SECTION PLAT

	o		

Location _____

Rig up _____

Drilling and Remarks:

407/10 lbs.

RECORD

Cased _____ in., _____ ft.

Sand 1203-1223

Gas _____

Oil _____

Total Depth 1220

PRODUCTION

1st 24 hrs. Nat. _____

1st 24 hrs. after shot _____

Gas _____ Cu. Ft.

Dry Hole _____

Abandoned _____

Date

JAN 8 1927

CHAS. L. SHERWOOD

192

Scout