

Section 4 Township 20 Range 10WWell No. #2 KnopCompany Laura Jane Oil

NORTH

		0					

WEST

EAST

SOUTH

Rice

HOT FILE KANSAS

Sec. 4 Twp. 20 R. 10 W ✓

Well No. # 2 Knop Farm

Laura Jane Oil Company

Contractor

Silica Pool


Ft. from N. Line

990 Ft. from S. Line

990 Ft. from E. Line

Ft. from W. Line

NW SE NW

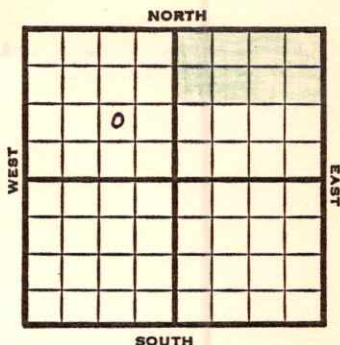

1951

Elev. 1794'

REPORT

2/14

Spud 2-7-51
8" @190
Drlg. 1760


5/2

Spud 2-7-51
Oil Well TD 3343
8" @ 190
Heeb. 2894 Br Lime 3015
Lans. 3031 Simp 3324
Arb. 3336-38
4½" @ 3336 DST 3320-38 opn 1 hr
Rec. 30' mud DD 3343 FU 200'
oil 1½ hr 1100' oil 6 hr.
Comp. 10 bopd

COMPLETED

J. E. TYRA

County Rice State Kansas
 Sec. 4 (Blk. 20 (Sur. 10W Map No.
 (Twp.) (Rge.)
 Operator Laura Jane Oil
 Well No. 2 Farm Knop
 Elev. 1794 Location NW SE NW

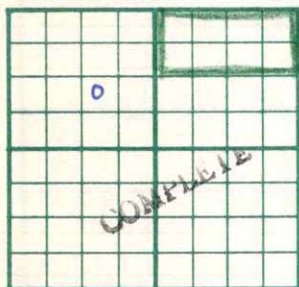

990 Ft. From S Line NW
990 Ft. From E Line Quarter
 1st. Report
 Completion MAY 2 1951
 Remarks Silica Pool

Spudding Date 2-7-51

Drlg. Data Oil well TD 3343

8" @ 190 Heeb. 2894 Br. lime 3015

Lans. 3031 Simp. 3324 Arb. 3336-38

4½" @ 3336 DST 3320-38 open 1 hr.

Rec. 30' mud DD 3343 FU 200' oil 1½ hr.

1100' oil 6 hr. Comp. 10 bopd

J. E. TYRA