


Map No. 15 Sec. 21 Twp. 30 R. 11E  
 Well No. 4 - Fleeck Farm  
York State oil Company

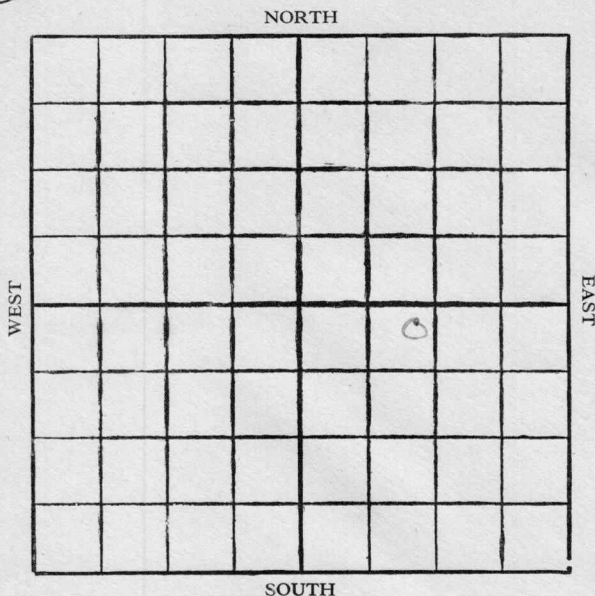

Location .....

Drilling Remarks .....

.....

.....

Rig Up .....

Drilling Remarks .....

.....

.....

**RECORD**

Cased ..... in. .... ft.

Sand .....

Gas .....

Oil .....

Total Depth .....

**PRODUCTION**

1st 24 hrs. Nat. ....

1st 24 hrs. after shot .....

Gas ..... cu. ft.

Dry Hole .....

Abandoned .....

ELK


Map No. Kansas Sec. 21 Twp. 30 R. 11<sup>E</sup>Well No. 4 Fleer FarmYork State Oil Company

NORTH

200 Ft. from N. Line

Ft. from S. Line

Ft. from E. Line

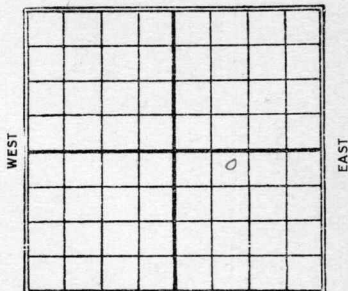1120 Ft. from W. Line

Date

REPORT

19271/8 Sdy shale 1261-65Show OilSdy shale 1425-45 ShsTas + OilAbandoned 1451

7 KANSAS 21 30 11<sup>8</sup>  
 Map No. Sec. Twp. R.

Well No. 4 Fleck  
 York State oil Co Company

Contractor

## FIRST REPORTS

## SECTION PLAT

200 Ft. from N. Line

Ft. from S. Line

Ft. from E. Line

1120 Ft. from W. Line

COMPLETED

|  |  |  |  |
|--|--|--|--|
|  |  |  |  |
|  |  |  |  |
|  |  |  |  |
|  |  |  |  |

ABANDONED

Location

Rig up

Drilling and Remarks:

Sdy shale 1261-65

shows oil

Sdy shale 1425-45

shows gas & oil

NEW 1450

## RECORD

Cased in., ft.

Sand

Gas

Oil

Total Depth 1451

## PRODUCTION

1st 24 hrs. Nat.

1st 24 hrs. after shot

Gas Cu. Ft.

Dry Hole ✓

Abandoned ✓

Date

JAN 8 1927

CHAS. L. SHERWOOD

192

Scout