

EAST

SOUTH


Drilling Remarks

Abandoned -----

ELK

Map No. Kansas Sec. 28 Twp. 30 R. 11EWell No. 1 Hughes FarmL. K. Oil Company

NORTH

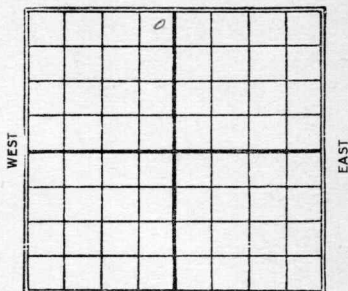

WEST

EAST

SOUTH

200 Ft. from N. Line

_____ Ft. from S. Line

200 Ft. from E. Line

_____ Ft. from W. Line

Date

1927

REPORT

1/8 Top Line 1783
Abandoned 1853

9 KANSAS 28 30 11
 Map No. Sec. Twp. R.
 Well No. 1 Hughes
 L. H. O'D Co. Company

Contractor

FIRST REPORTS

SECTION PLAT

200 Ft. from N. Line

Ft. from S. Line

200 Ft. from E. Line

Ft. from W. Line

COMPLETED

	0		
ABANDONED			

Location

Rig up

Drilling and Remarks:

th 1783

RECORD

Cased in., ft.

Sand

Gas

Oil

Total Depth 1853

PRODUCTION

1st 24 hrs. Nat.

1st 24 hrs. after shot

Gas Cu. Ft.

Dry Hole ✓

Abandoned ✓

Date

JAN 8 1927

CHAS. L. SHERWOOD

192

Scout