


Map No. Kansas Sec. 22 Twp. 27 R. 7

Well No. 3 Harris Farm

Mid-Kansas Company

NORTH

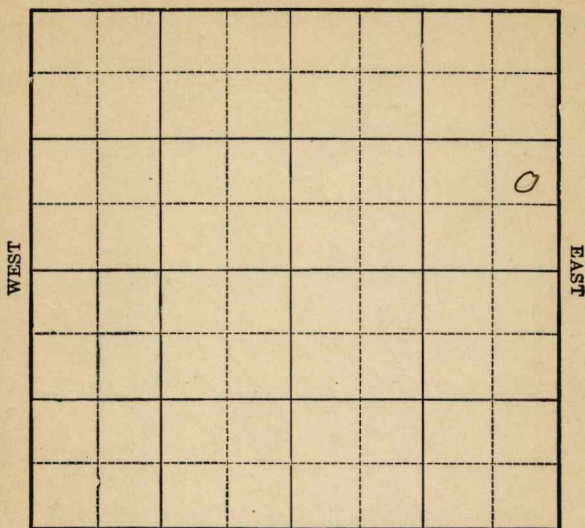

SOUTH

Location _____

Drilling Remarks _____

Rig Up _____

Drilling Remarks _____

RECORD

Cased _____ in. _____ ft.

Sand _____

Gas _____

Oil _____

Total Depth _____

PRODUCTION

1st 24 hrs. Nat. _____

1st 24 hrs. after shot _____

Gas _____ cu. ft.

Dry Hole _____

Abandoned _____

Butler


Map No. KANS Sec. 22 Twp. 27 R. 7Well No. 3 Harris FarmMid-Kansas Company

Ft. from N. Line

990 Ft. from S. Line330 Ft. from E. Line

Ft. from W. Line

NORTH

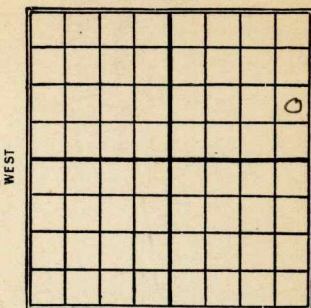

SOUTH

1926

Date

REPORT

7/21 Location

7/28 timbers

8/4 Bldg rig

8/11 rig

8/18 Spudding

8/25 Drly 400'

8-31 " 1100'

9/15 " 1885'

9/22 " 2176'

9/29 " 2687'

10/6 sand 2710-2726

20/40 barrel

Map No. **K10 KANSAS** Sec. **22** Twp. **27** R. **7**

Well No. **3** **Harris**

Contractor

FIRST REPORTS

SECTION PLAT

			0

----- Ft. from N. Line

990 ----- Ft. from S. Line

330 ----- Ft. from E. Line

----- Ft. from W. Line

Location ----- ✓

Rig up -----

Drilling and Remarks:

RECORD

Cased ----- in., ----- ft.

Sand -----

Gas -----

Oil -----

Total Depth -----

PRODUCTION

1st 24 hrs. Nat. -----

1st 24 hrs. after shot -----

Gas ----- Cu. Ft.

Dry Hole -----

Abandoned -----

Date

JUL 21 1926

CHAS. L. SHERWOOD


192

Scout

Butler

10 **KANSAS** 22 27 R. 7
 Map No. Set. Twp. R.
 Well No. 3 Harris Farm
 Mid-Kansas Company

NORTH

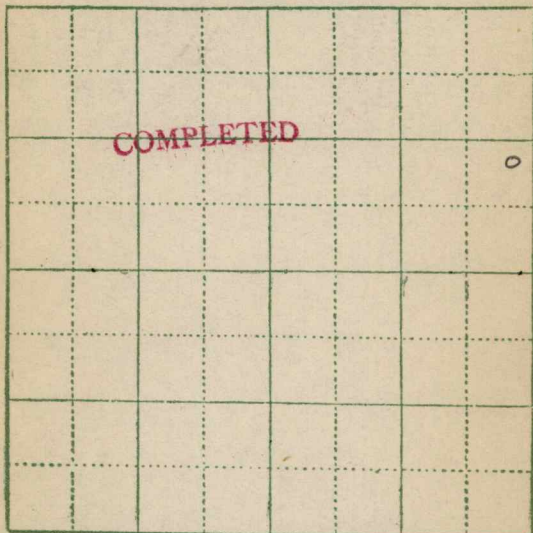

SOUTH

Location _____

Rig up _____

Drilling and Remarks:

2a
/ 40 BS.

RECORD

Cased _____ in., _____ ft.

Sand 2710-2726

Gas _____

Oil _____

Total Depth 2726

PRODUCTION

1st 24 hrs. Nat. _____

1st 24 hrs. after shot _____

Gas _____ Cu. Ft.

Dry Hole _____

Abandoned _____

Date

OCT 6 1926

CHAS. L. SHERWOOD

Scout