


LOCATION NOTICE

TULSA, OKLA., October 2, 1936 193WELL NO. TWO (2) ON C.A. WOOD FARM

WILL BE AS FOLLOWS:

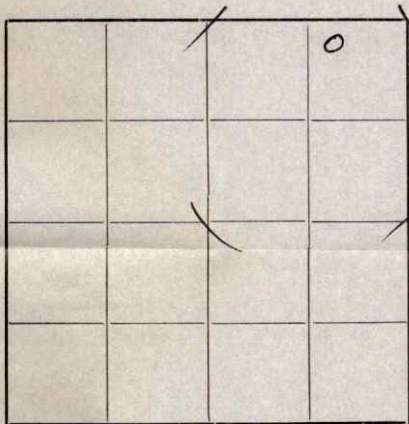

330 FEET FROM NORTH LINE

990 FEET FROM EAST LINE

FEET FROM SOUTH LINE

FEET FROM WEST LINE

IN NE 1/4 SEC. 4 TWP. 20S RANGE 10WRice COUNTY, STATE OF Kansas

REMARKS:

COPIES TO

SIGNED [Signature]

DISTRICT SUPT.
 ACCOUNTING DEPT.
 RENTAL DEPT.
 SCOUTING DEPT. ✓
 ENGINEERING DEPT.
 LEGAL DEPT.
 CLAIM DEPT.
 TAX DEPT.
 GEOLOGICAL DEPT.
 FILE
 LEASE INVENTORY

[Signature]
[Signature]