

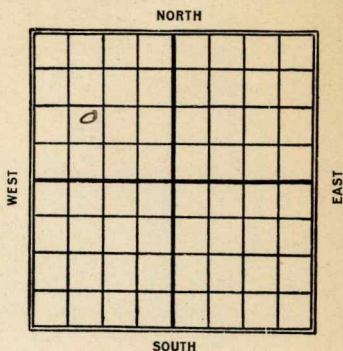
Butler

Map No. 15 Sec. 23 Twp. 27 R. 7Well No. 4 Harris Acct # 2 FarmMid-Kansas Company

Ft. from N. Line

1120 Ft. from S. Line

Ft. from E. Line

1120 Ft. from W. Line1926

Date

REPORT

10/27 Bldg rig11/11 Spudding11/17 same11/23 Same12/8 Drilg 870'12/15 " 1350'12/22 " 210012/30 " 237519271/6 sand 2691-2753

80/125 bbls

J.D. 2753

10 **KANSAS** *Butter*
 Map No. _____ Sec. *23* Twp. *27* R. *7*
 Well No. *4 Harris Acct #2*
Mid-Kansas _____ Company _____

Contractor _____

FIRST REPORTS

_____ Ft. from N. Line

1120 _____ Ft. from S. Line

_____ Ft. from E. Line

1120 _____ Ft. from W. Line**SECTION PLAT**

<i>o</i>			

Location _____

Rig up _____

Drilling and Remarks: _____

RECORD

Cased _____ in., _____ ft.

Sand _____

Gas _____

Oil _____

Total Depth _____

PRODUCTION

1st 24 hrs. Nat. _____

1st 24 hrs. after shot _____

Gas _____ Cu. Ft.

Dry Hole _____

Abandoned _____

Date

OCT 27 1926**CHAS. L. SHERWOOD**

192

Scout

Butter
 10 KANSAS 23 27 7
 Map No. Sec. Twp. R.
 Well No. 4 Harris Acct #2
 Mud-15 hrs. Co. Company

Contractor

COMPLETED

SECTION PLAT

Ft. from N. Line

1120 Ft. from S. Line

Ft. from E. Line

1120 Ft. from W. Line

0			

Location

Rig up

Drilling and Remarks:

807 125 BS

RECORD

Cased in, ft.

Sand 2691-2753

Gas

Oil

Total Depth 2753

PRODUCTION

1st 24 hrs. Nat.

1st 24 hrs. after shot

Gas Cu. Ft.

Dry Hole

Abandoned

Date

JAN

6 1927

CHAS. L. SHERWOOD

192

Scout