


Section 4 Township 20 Range 10-W

Well Number 5 Wood


Company Mid Continent Pet.

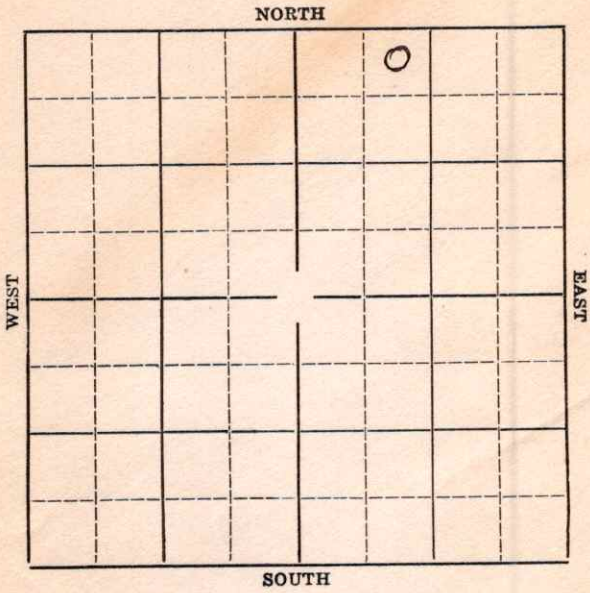

Sec. 4 Twp. 20 R. 10-WWell No. #5 Wood FarmMid-Continent Pet. Company330 Ft. from N. Line

Ft. from S. Line

Ft. from E. Line

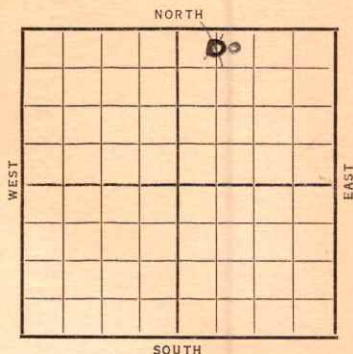990
660 Ft. from W. LineElev. 1796Date
1937

REPORT

3/10

Cellar

3/18

250' - 12" WOC

3/20

Dlg. 1480 (Tel)

3/25

Drlg. 2185' • 3313

3/30

Top Siliceous 3317

Cored 3317-²³~~27~~ Showed saturationT.D. ³³²³~~3327~~ (Tel)

4/1

Top Siliceous 3313

Total Depth 3323 (Corrections) - (Teleg)

4/6

Top Siliceous 3313

Core showed saturation

T.D. 3323 7" 3313

Will drill in tomorrow (Tel)

4/7

Drilling cement (Tel)

4/7

Drilled plug Filled up 2465 feet oil
 in 35 minutes Filled up hole full oil
 in $1\frac{1}{2}$ hours Will clean out to bottom
 and give swabbing test

Estimate 2000 to 2500 bbl. well (Tel)

OVER

1937

4/9--**Top Siliceous 3313** 7" 3313 TD 3323

1st hour swab	43 $\frac{1}{2}$	bbls.	
2nd "	"	92	bbls.
3rd "	"	87	"
4th "	"	92	"
5th "	"	103	"
6th "	"	97	"
7th "	"	43	" (Down 40 minutes)
8th "	"	65	" (Down 20 minutes)
9th "	"	97	"
10th "	"	87	"
11th "	"	92	"

Never swabbed below 1000 feet (Tel)

4/14--Potential 2581 bbls. (Telegram)

4/14 **Sil. 3313'.**

T.D. 3323'.

1000 acid.

Potential 2581.

COMPLETED

6/25/37--60 day retest 2750 bbls. (Telegram)

10/11/37--New potential ²⁹⁰¹~~2787~~ bbls. (Tel)

10/13/37--Correction--new potential 2901 bbls.
(Tel)

Map No. _____ Sec. 4 Twp. 20 R. 10W.Well No. 5 WoodMid-Continent Pet. Company

Contractor _____

Special

SECTION PLAT

			0

330 Ft. from N. Line

_____ Ft. from S. Line

_____ Ft. from E. Line

~~660~~ Ft. from W. Line

FIRST REPORT

Location _____

Rig up _____

Drilling and Remarks:

@ & Har

RECORD

Cased _____ in., _____ ft.

Sand _____

Gas _____

Oil _____

Total Depth _____

PRODUCTION

1st 24 hrs. Nat. _____

1st 24 hrs. after shot _____

Gas _____ Cu. Ft.

Dry Hole _____

Abandoned _____

Date

MAR 10 1937 19

S. J. LEWIS Scout

Map No. _____ Sec. 4 Twp. 20 R. 10W

Well No. 5 Wood

Mid-Continent Pet Company

Contractor

SECTION PLAT

		0	

330 Ft. from N. Line

_____ Ft. from S. Line

_____ Ft. from E. Line

990 Ft. from W. Line

COMPLETED

Location _____

Rig up _____

Drilling and Remarks:

*Bit 3313
1000 acid*

*Potential
2581*

RECORD

Cased _____ in., _____ ft.

Sand _____

Gas _____

Oil _____

Total Depth 3323

PRODUCTION

1st 24 hrs. Nat. _____

1st 24 hrs. after shot _____

Gas _____ Cu. Ft.

Dry Hole _____

Abandoned _____

Date

APR 14 1937 19

S. J. LEWIS

Scout