


Map No. 15 Sec. 30 Twp. 30 R. 11E

Well No. 4 - Pickell Farm
Pennock Oil Company

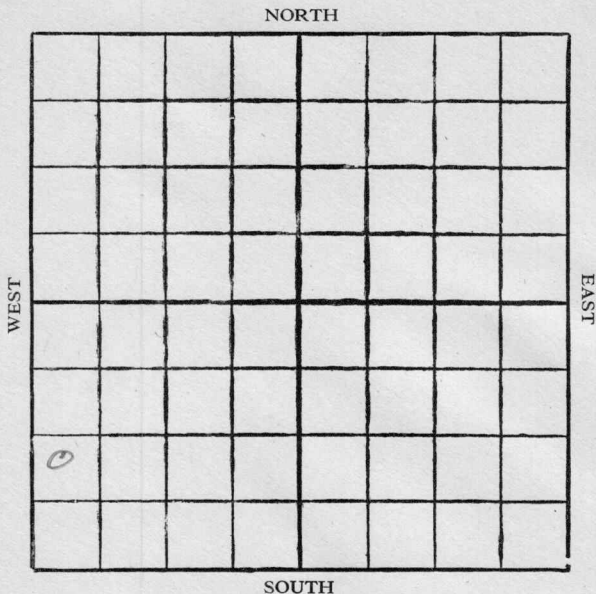

Location

Drilling Remarks

.....

.....

RECORD

Cased in. ft.

Sand

Gas

Oil

Total Depth

Rig Up

Drilling Remarks

.....

.....

PRODUCTION

1st 24 hrs. Nat.

1st 24 hrs. after shot

Gas cu. ft.

Dry Hole

Abandoned

ELK

Map No. Kansas Sec. 30 Twp. 30 R. 11^E


Well No. 4 Pickell Farm
Penrock oil Company

..... Ft. from N. Line

1120 Ft. from S. Line

..... Ft. from E. Line

200 Ft. from W. Line

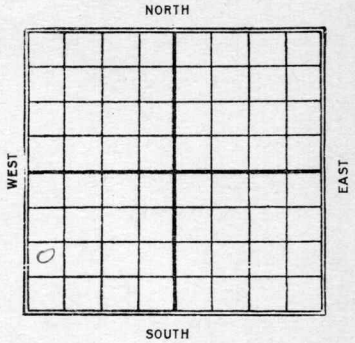

Date
1927

REPORT

1/8 Sand 1175-1181 50 bbls
37 Gravity

9 KANSAS 30 30 11 4
 Map No. _____ Sec. _____ Twp. _____ R. _____

Well No. 4 Puckell
 Kennock Oil Co. _____ Company

_____ Contractor

FIRST REPORTS

SECTION PLAT

_____ Ft. from N. Line

1120 _____ Ft. from S. Line

_____ Ft. from E. Line

200 _____ Ft. from W. Line

0			

COMPLETED

Location _____

Rig up _____

Drilling and Remarks:

50 lbs.
 37 Security.

RECORD

Cased _____ in., _____ ft.
 Sand 1175-1181 _____
 Gas _____
 Oil _____
 Total Depth 1181 _____

PRODUCTION

1st 24 hrs. Nat. _____
 1st 24 hrs. after shot _____
 Gas _____ Cu. Ft.
 Dry Hole _____
 Abandoned _____

Date

JAN 8 1927

CHAS. L. SHERWOOD

192

Scout