

Butler


KANSAS

FORM 51 5M 4-41 PETROL

Section 23 Township 27 Range 7E

Well No. 26 Keighly

Company Phillips

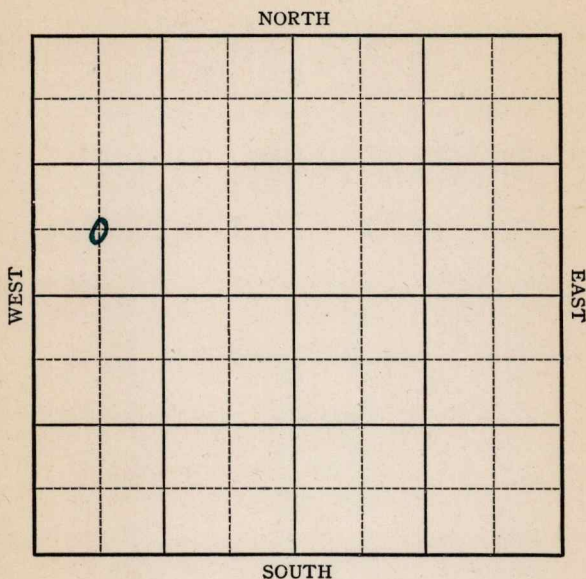


KANSAS

Butler

Sec. 23 Twp. 27 R. 7-EWell No. #26 Keighly FarmPhillips Company

(Keighly)

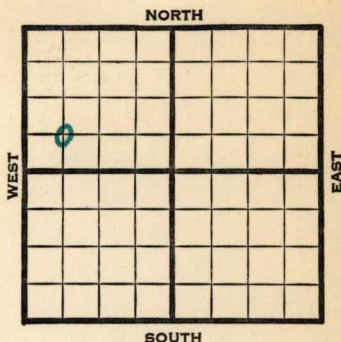 Ft. from N. Line660 Ft. from S. Line Ft. from E. Line660 Ft. from W. Line

1941

REPORT

7/16 8" - 133' WOC.

7/24 KC 2034' Drlg. 2310'

7/31 " " " "

8/7 Viola 3153-64 TD 5" @ 3153 RUST

8/15 125' oil in 8 hrs

8/20 Viola 3153'

5" - 3153'

T.D. 3164'

500 acid.

Potential 293 bbls., pump.

36. Gravity

COMPLETED

Map No. 10 Sec. 23 Twp. 27 R. 7EWell No. 26 KeighlyPhillips

Company

Contractor

FIRST REPORT

C SW NW

Ft. from N. Line

660

Ft. from S. Line

Ft. from E. Line

660

Ft. from W. Line

KEIGHLY POOL

SECTION PLAT

o			

Location

Rig up

Drilling and Remarks:

8" - 138 WOC

RECORD

Cased _____ in., _____ ft.

Sand _____

Gas _____

Oil _____

Total Depth _____

PRODUCTION

1st 24 hrs. Nat. _____

1st 24 hrs. after shot _____

Gas _____ Cu. Ft.

Dry Hole _____

Abandoned _____

Date

JUL 16 1941

19

S. J. LEWIS

Scout

Map No. 10 Sec. 23 Twp. 27 R. 7EWell No. 26 KeighlyPhillips

Company

COMPLETED

Contractor

SECTION PLAT

C SW NW

Ft. from N. Line

660 Ft. from S. Line

Ft. from E. Line

660 Ft. from W. Line

0			

KEIGHLY POOL

Location _____

Rig up _____

Drilling and Remarks:

*Viola 8153**5" 03153**500 acal**Pump 293 R8**36 1/2 Gr.*

RECORD

Cased _____ in., _____ ft.

Sand _____

Gas _____

Oil _____

Total Depth 3164

PRODUCTION

1st 24 hrs. Nat. _____

1st 24 hrs. after shot _____

Gas _____ Cu. Ft.

Dry Hole _____

Abandoned _____

Date

AUG 20 1941

19

S. J. LEWIS

Scout