

Butler

KANSAS


SECTION 23 TOWNSHIP 27S RANGE 7E

WELL NO. REIGHLEY #1 Keely Unit "B"

COMPANY White & Ellis

NORTH

C w/2 NW  
~~SE SW SW NW~~

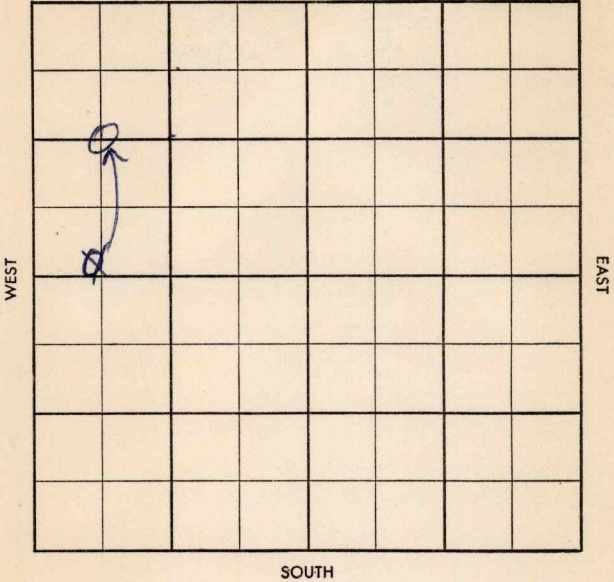


~~Top~~ ~~Pool~~  
~~Co.~~ ~~First~~

County Butler Elev. \_\_\_\_\_  
Sec. 23 Twp. 27 Rge. 7E  
Company White & Ellis  
Farm Name Keely Unit "B" No. 1

TOPS	DEPTH	LOG	DATUM
Anh.			
Tp.			
H.			
Tr.			
Dg.			
B.L.			
L.			
K.C.			
B.K.C.			
Ce.			
C.			
M.			
M.			
K.			
Mz.			
Mq.			
V.			
S.			
S.			
A.			
R.			
Pf.			
G.			
T.D.			

Loc. in Sec. \_\_\_\_\_  
**SE SW SW NW**  
Geol. \_\_\_\_\_  
Contr. \_\_\_\_\_  
**Co. Tools #2**  
Pool \_\_\_\_\_  
**Keighley**

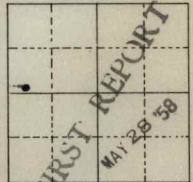

Date Comm. \_\_\_\_\_  
**MI**

Co.  
Lse.  
No.  
Sec.  
T.  
R.

Twp. ~~23~~ Pool ~~X~~  
 Co. ~~X~~ Facet ~~X~~  
**CORRECTION**

5-513-B

County Butler Elev. 14950E 149300  
 Sec. 23 Twp. 27 Rge. 7E  
 Company White & Ellis  
 Farm Name Keighley Keely Unit "B" No. 1

TOPS	DEPTH	LOG	DATUM	Loc. in Sec.
Anh.				<u>SE SW SW NW</u>
Tp.				<u>C W / 2 NW</u>
H.				
Tr.				
Dg.				
B.L.				
L.	<u>1717</u>			
K.C.	<u>Blsg 1862</u>			Geol.
B.K.C.	<u>KC 2022</u>			Contr.
Ce.	<u>BKC 2195</u>			Co. Tools #2
C.	<u>137VT 2669</u>			Pool
M.				<u>Keighley</u>
M.				<div style="border: 1px solid black; padding: 5px; text-align: center;"> <b>COMPLETE</b>            *            JUL 16 '58         </div>
K.				
Mz.				
Mq.				
V.				
S.				
S.				
A.				
R.				
Pf.				
G.				
T.D.	<u>2673</u>			

Date Comm. 5-28-58 8" 168  
MI JUN 3 '58 5" 2670 WOC  
JUN 11 '58 JUN 18 '58 CO DD 2701 TD prac  
JUN 25 '58 JUL 2 '58 JUL 9 '58 pop JUL 15 '58  
P 3730 3090W pd  
P 25 B08 d + 3090W  
Bart 2670-2701

Co.  
No.  
Sec.  
T.  
R.