


Section 23 Township 27 Range 7-E

Well No. #25 Keighly Unit

Company Phillips

NORTH **Keighly Pool**

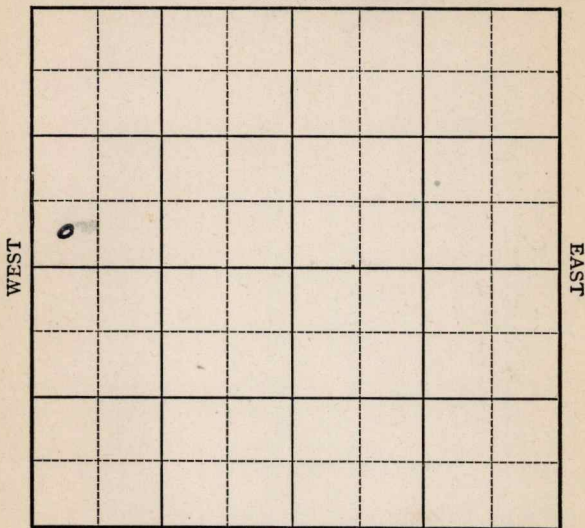

SOUTH

Sec. 23 Twp. 27 R. 7-E

Well No. #25 Keighly Unit Farm

Phillips Company


(Keighly)

_____ Ft. from N. Line

50 Ft. from S. Line

_____ Ft. from E. Line

50 Ft. from W. Line

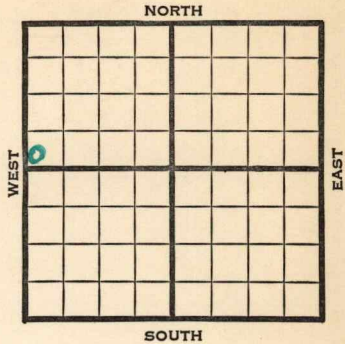

Elev. 1525

| 1941 | REPORT |
|------|---|
| 4/23 | Location |
| 5/1 | 8" - 123' WOC. |
| 5/8 | K.C. 2030' Drlg. 2500' |
| 5/15 | Bart. 2700' B. Bart. 2760' Miss. 2760' Drlg. 3035' |
| 5/22 | Dolomite 3147' 5" - 3147' T.D. 3158' SSO. |
| 5/28 | " " " |
| 6/5 | " " " |
| 6/12 | " " " |
| 6/18 | Viola 3147' 5" - 3147' T.D. 3158' 500 acid. Potential 297 bbls., pump. 32. Gravity |
| | COMPLETED |

Map No. 10 Sec. 23 Twp. 27 R. 7E

Well No. 25 Keighly Unit

Phillips

Company

FIRST REPORT

Contractor

SECTION PLAT

SW NW

| | | | |
|--|--|--|--|
| | | | |
| | | | |
| | | | |
| | | | |

 Ft. from N. Line

50 Ft. from S. Line

 Ft. from E. Line

50 Ft. from W. Line

KEIGHLY POOL

Location X

Rig up

Drilling and Remarks:

RECORD

Cased in., ft.

Sand

Gas

Oil

Total Depth

PRODUCTION

1st 24 hrs. Nat.

1st 24 hrs. after shot

Gas Cu. Ft.

Dry Hole

Abandoned

Date

APR 23 1941

S. J. LEWIS

Scout

