


LOCATION NOTICE

TULSA, OKLA. March 8, 1937 193.....

WELL NO. Five (5) ON C. A. Wood FARM

WILL BE AS FOLLOWS:

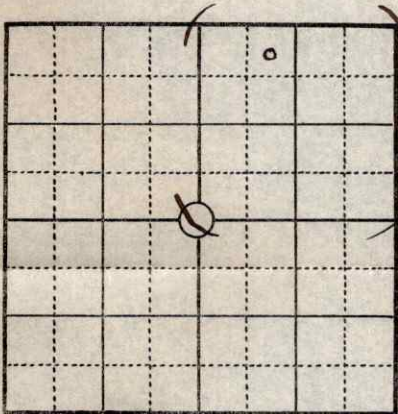

330' FEET FROM NORTH LINE

FEET FROM EAST LINE

FEET FROM SOUTH LINE

990' FEET FROM WEST LINE

IN NE 1/4 SEC. 4 TWP. 20S RANGE 10W

Rice COUNTY, STATE OF Kansas

REMARKS:

E. A. Dymond --- Foreman

COPIES TO SIGNED [Signature]

- DISTRICT SUPT.
- ACCOUNTING DEPT.
- RENTAL DEPT.
- SCOUTING DEPT. ←
- ENGINEERING DEPT.
- LEGAL DEPT.
- CLAIM DEPT.
- TAX DEPT.
- GEOLOGICAL DEPT.
- FILE
- LEASE INVENTORY

[Signature]
[Signature]