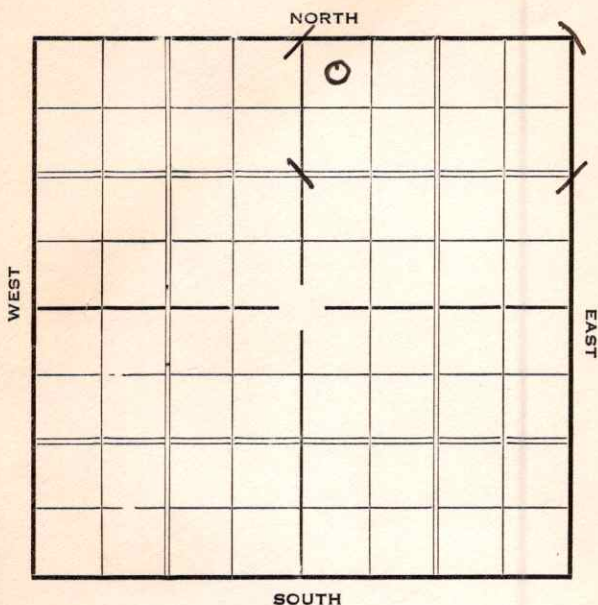
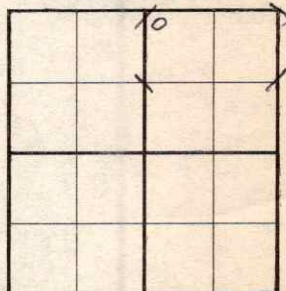


KANSAS

Section 5 Township 20 Range 10-WWell Number 1 PoncinCompany Tatlock

KANSAS *Pice*Map No. 46 Sec. 5 Twp. 20 R. 10 W.Well No. 1 PoncinTatlock Company

Contractor

SECTION PLAT330 Ft. from N. Line Ft. from S. Line Ft. from E. Line380 Ft. from W. Line**FIRST REPORT**Location ✓Rig up

Drilling and Remarks:

RECORDCased in., ft.Sand Gas Oil Total Depth **PRODUCTION**1st 24 hrs. Nat. 1st 24 hrs. after shot Gas Cu. Ft.Dry Hole Abandoned

Date

MAR 24 1937

19

S. J. LEWIS

Scout

Rice KANSAS

Map No. _____ Sec. 5 Twp. 20 R. 10^WWell No. 1-PoncaJ. H. Tatlock Company

Contractor

COMPLETED**SECTION PLAT**

		0	

330 Ft. from N. Line

_____ Ft. from S. Line

_____ Ft. from E. Line

330 Ft. from W. Line

Location _____

Rig up _____

Drilling and Remarks:

*Pumped**230 oil in 2 $\frac{3}{4}$ hrs**(Refuses To Take any more Tests)***RECORD**

Cased _____ in., _____ ft.

Sand 51 3286

Gas _____

Oil _____

Total Depth 3293**PRODUCTION**

1st 24 hrs. Nat. _____

1st 24 hrs. after shot _____

Gas _____ Cu. Ft.

Dry Hole _____

Abandoned _____

Date **APR 28 1937**

19

H. D. Hatfield Scout