


Section 5 Township 20 Range 10-W


Well Number 1 - Poncin

Company Gulf

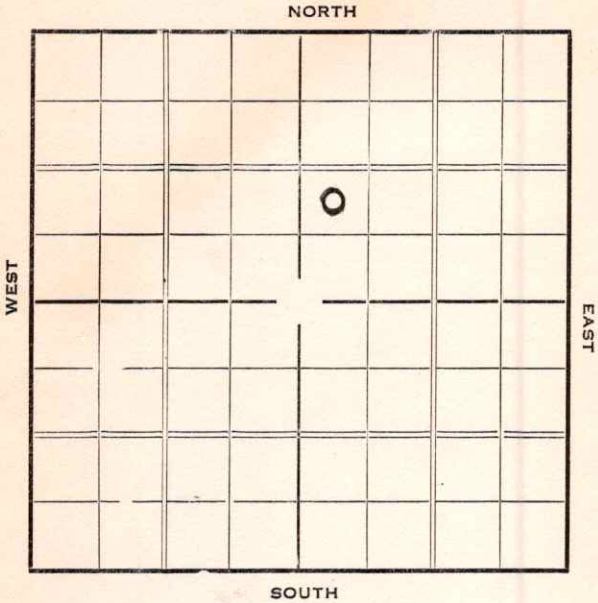

Sec. 5 Twp. 20 R. 10-WWell No. #1 Poncin FarmGulf Company Ft. from N. Line990 Ft. from S. Line Ft. from E. Line330 Ft. from W. Line

Elev. 1811

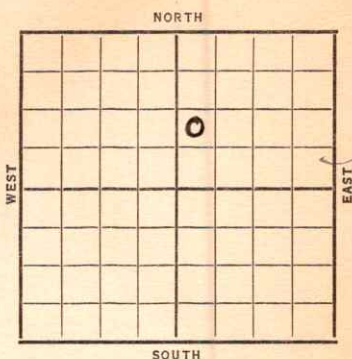

Date	REPORT
1937	
4/28	B. R.
5/7	10" @ 165'. Drlg. 250'.
5/14	Drlg. 3015'.
5/21	Sil. 3217'-20'.
	6" @ 3218'. H.F.O.
5/28	T.D. 3227'. 3000 acid.
6/2	6" @ 3318'.
	Sil. 3317'(Corrected)
	T.D. 3327'(Corrected)
	3000 acid.
	Pot. 1409 bbls.

COMPLETED

Rice
KANSASMap No. _____ Sec. 5 Twp. 20 R. 10^wWell No. 1 - PorcupineGulf Company

Contractor _____

FIRST REPORT

_____ Ft. from N. Line

990 Ft. from S. Line

_____ Ft. from E. Line

330 Ft. from W. Line**SECTION PLAT**

		0	

Location _____

Rig up _____

Drilling and Remarks:

*B.R.***RECORD**

Cased _____ in., _____ ft.

Sand _____

Gas _____

Oil _____

Total Depth _____

PRODUCTION

1st 24 hrs. Nat. _____

1st 24 hrs. after shot _____

Gas _____ Cu. Ft.

Dry Hole _____

Abandoned _____

Date

APR 28 1937

19

H. D. Hatfield Scout

KANSAS

Map No. 46 Sec. 5 Twp. 20 R. 10 ^WWell No. 1 - PoncaCompany Gulf

Contractor _____

COMPLETED

SECTION PLAT

		0	

_____ Ft. from N. Line

990 Ft. from S. Line

_____ Ft. from E. Line

330 Ft. from W. Line

Location _____

Rig up _____

Drilling and Remarks:

3000 AcidPat - 1409

RECORD

Cased 6 in., 3318 ft.~~Sand~~ Sil 3317Gas (corrected)

Oil _____

Total Depth 3327

PRODUCTION

1st 24 hrs. Nat. _____

1st 24 hrs. after shot _____

Gas _____ Cu. Ft.

Dry Hole _____

Abandoned _____

Date

JUN 2 1937 19H. D. Hatfield

Scout