


KANSAS

Barton

Section 13 Township 20 Range 12W
 Well No. #1 Schlessinger (*Schlessinger*)
 Company R. L. Williams

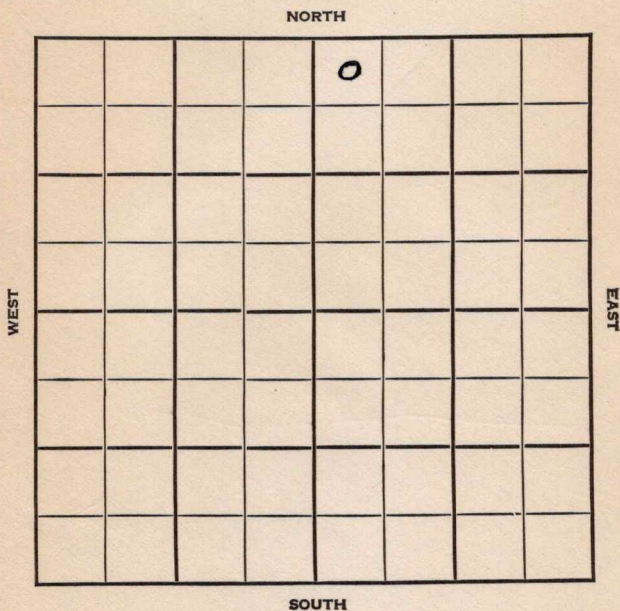

KANSAS

Barton

Sec. 13 Twp. 20 R. 12W

Well No. #1 Schlessiger Farm

R. L. Williams

Company

Marchand Pool


330' Ft. from N. Line

Ft. from S. Line

Ft. from E. Line

330' Ft. from W. Line

NW NE

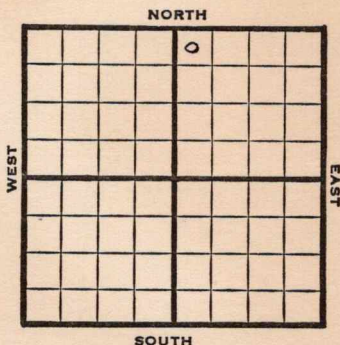

1948

Eli 1789'

REPORT

6/9 Location

6/16 8" @ 268'
Drlg. 1850'

6/23 **Lansing 3088'**
Arbuckle 3330
TD 3358
5"@ 3335'
RUST

6/29 "

7/14 TD 3358'
Arb. 3330'
5"@ 3335'
1000 acid
Pump 100 oil Pot
41° Gr.
Comp.

COMPLETED

Map No. _____ Sec. 13 Twp. 20 R. 12W

Well No. 1 Schlessiger


R. L. Williams Company

FIRST REPORT

Contractor

NW NE

SECTION PLAT

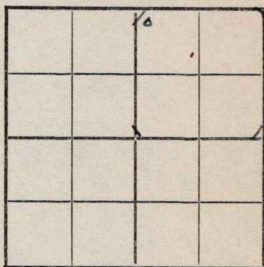

330 Ft. from N. Line

_____ Ft. from S. Line

_____ Ft. from E. Line

330 Ft. from W. Line

Barton County

Location X

Rig up _____

Drilling and Remarks:

RECORD

Cased _____ in., _____ ft.

Sand _____

Gas _____

Oil _____

Total Depth _____

PRODUCTION

1st 24 hrs. Nat. _____

1st 24 hrs. after shot _____

Gas _____ Cu. Ft.

Dry Hole _____

Abandoned _____

Date

JUN 9 1948 19 _____ S. J. LEWIS Scout

Map No. 46 Sec. 13 Twp. 20 R. 12W

Well No. 1 Schlessiger

R. L. Williams Company

COMPLETE

Contractor

NW NE

E. 11789
SECTION PLAT

330 Ft. from N. Line

 Ft. from S. Line

 Ft. from E. Line

330 Ft. from W. Line

		0	

Barton County

Location

Rig up

Drilling and Remarks:

CR Y3330

5" C3335

1000 acid

Pump 100 oil 80

4 1/2 in.

RECORD

Cased in., ft.

Sand

Gas

Oil

Total Depth 235

PRODUCTION

1st 24 hrs. Nat.

1st 24 hrs. after shot

Gas Cu. Ft.

Dry Hole

Abandoned

Date

JUL 14 1948

19

S. J. LEWIS

Scout