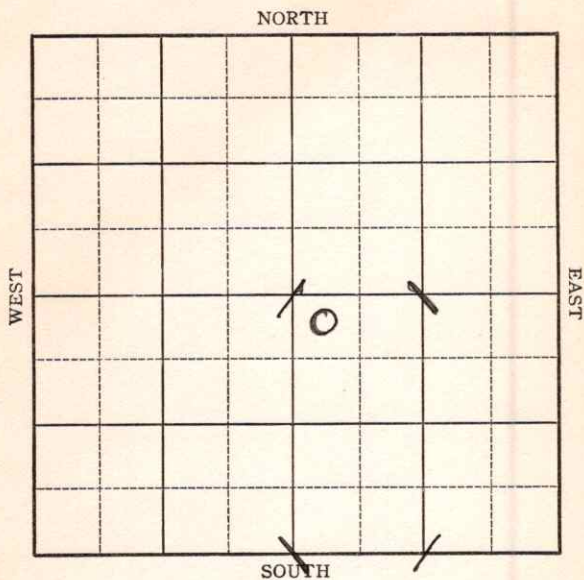


Rice

KANSAS

Section 5 Township 20 Range 10-WWell No. 1 - StuederCompany J. H. Tatlock

Rice


KANSAS

Map No. 46 Sec. 5 Twp. 20 R. 10 WWell No. 1 - StuederJ. H. Tatlock Company

Contractor

FIRST REPORT

SECTION PLAT

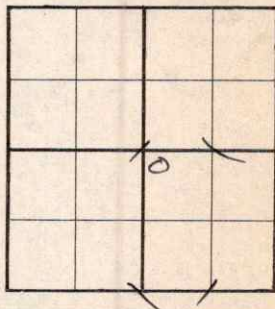330 Ft. from N. Line Ft. from S. Line Ft. from E. Line330 Ft. from W. LineLocation Rig up

Drilling and Remarks:

BRR.

RECORD

Cased in., ft.Sand Gas Oil Total Depth

PRODUCTION

1st 24 hrs. Nat. 1st 24 hrs. after shot Gas Cu. Ft.Dry Hole Abandoned

Date

JUN 9 1937 19H. D. Hatfield Scout

*Rice*Map No. 46 Sec. 5 Twp. 20 R. 10^wWell No. 1 - StuederJ. H. Tatlock Company

Contractor

COMPLETED**SECTION PLAT**330 Ft. from N. Line Ft. from S. Line Ft. from E. Line330 Ft. from W. Line

		0	

Location Rig up

Drilling and Remarks:

1000 AcidPump 276/6 hrsPat - 1074**RECORD**Cased 7 in., 3334 ft.Sand Si 1 3334Gas Oil Total Depth 3340**PRODUCTION**1st 24 hrs. Nat. 1st 24 hrs. after shot Gas Cu. Ft.Dry Hole Abandoned

Date

H. D. HatfieldJUL 21 1937 19

Scout