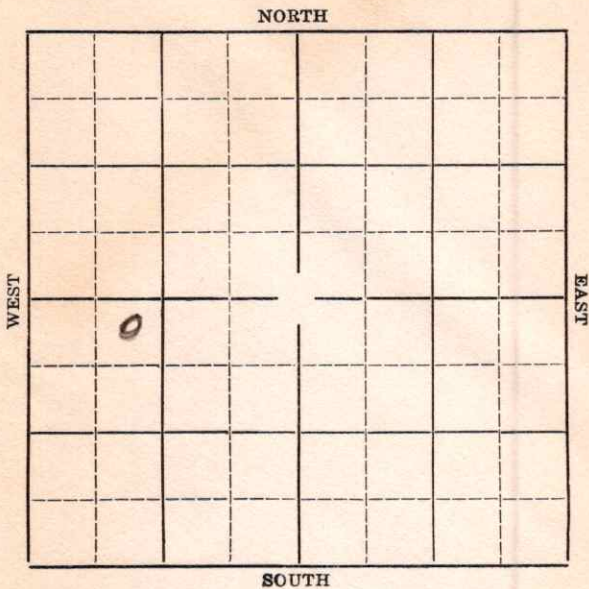


Section 5 Township 20 Range 10-WWell Number #2 DrewCompany Tatlock

KANSASMap No. 46 Sec. 5 Twp. 20 R. 10WWell No. 2 Drew.Hatlock Company

Contractor

SECTION PLAT

330 Ft. from N. Line

_____ Ft. from S. Line

_____ Ft. from E. Line

990 Ft. from W. Line**FIRST REPORT**Location ✓

Rig up _____

Drilling and Remarks:

RECORD

Cased _____ in., _____ ft.

Sand _____

Gas _____

Oil _____

Total Depth _____

PRODUCTION

1st 24 hrs. Nat. _____

1st 24 hrs. after shot _____

Gas _____ Cu. Ft.

Dry Hole _____

Abandoned _____

Date

NOV 4 1936 19

S. J. LEWIS Scout

Map No. 46 Sec. 5 Twp. 20 R. 10WWell No. 2. Drew.Thacker Company

Contractor

SECTION PLAT

0			

330 Ft. from N. Line

_____ Ft. from S. Line

_____ Ft. from E. Line

990 Ft. from W. Line

COMPLETED

Location _____

Rig up _____

Drilling and Remarks:

S. 63300P & Y. 1458Na J.

RECORD

Cased _____ in., _____ ft.

Sand _____

Gas _____

Oil _____

Total Depth 3316

PRODUCTION

1st 24 hrs. Nat. _____

1st 24 hrs. after shot _____

Gas _____ Cu. Ft.

Dry Hole _____

Abandoned _____

Date

DEC 9 1936 19S. J. LEWIS

Scout