

KANSAS

Barton

FORM 51 5M 4-41 PETROL

Section 13 Township 20 Range 12-W

Well No. #2 Schlessinger


Company Cities Service Oil

Marchand Pool

NORTH

WEST

EAST

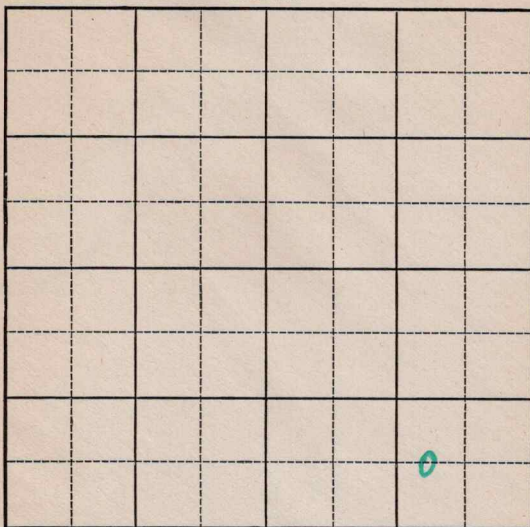

SOUTH

Map No. 46 Sec. 13 Twp. 20 R. 12WWell No. 2 SchlessigerCities Service Oil CompanyContractor

FIRST REPORT

C $W\frac{1}{2}$ SE SE Ft. from N. Line660 Ft. from S. Line990 Ft. from E. Line Ft. from W. Line

SECTION PLAT

			o

MARCHAND POOL

Location XRig up

Drilling and Remarks:

RECORD

Cased in., ft.Sand Gas Oil Total Depth

PRODUCTION

1st 24 hrs. Nat. 1st 24 hrs. after shot Gas Cu. Ft.Dry Hole Abandoned

Date

APR 16 1941 19

S. J. LEWIS

Scout

Map No. 46 Sec. 13 Twp. 20 R. 12WWell No. 2 SchlessigerCities Service Oil Company

Contractor

ABANDONED**SECTION PLAT**

			o

C $W\frac{1}{2}$ SE SE

Ft. from N. Line

660

Ft. from S. Line

990

Ft. from E. Line

Ft. from W. Line

MARCHAND POOL

Location _____

Rig up _____

Drilling and Remarks:

*Cor 8387**Noe hove***RECORD**

Cased _____ in., _____ ft.

Sand _____

Gas _____

Oil _____

Total Depth 3400**PRODUCTION**

1st 24 hrs. Nat. _____

1st 24 hrs. after shot _____

Gas _____ Cu. Ft.

Dry Hole _____

Abandoned _____

Date

APR 30 1941

19

S. J. LEWIS

Scout