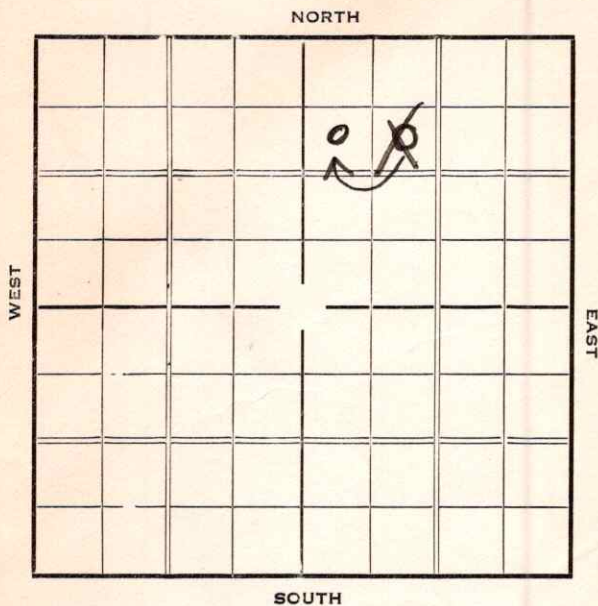



Section 5 Township 20 Range 10-WWell Number 2 PoncinCompany Tatlock

KANSAS

Rice

Sec. 5 Twp. 20 R. 10-WWell No. #2 Poncin FarmTatlock Company990 Ft. from N. Line Ft. from S. Line Ft. from E. Line330
~~990~~ Ft. from W. Line

Elev. 1803

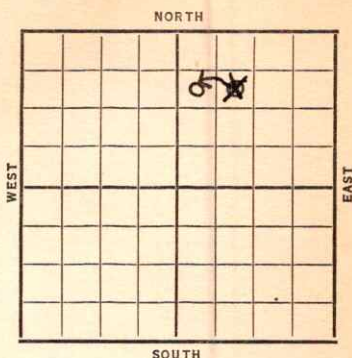

Date

REPORT

1937

3/24 Location

4/2 Rig

4/8 10" @ 135' Drlg. 730'

4/16 Drlg. 2904'.

4/23 Sil. 3293 $\frac{1}{2}$ '. Set 7".

T.D. 3294'. RUST.

4/28 Sil. 3293 $\frac{1}{2}$ '.

T.D. 3299'.

Pumped 271 oil in 3 hrs.

(Refuses to take 24 hr. test)

COMPLETED

KANSAS *Rice*Map No. 46 Sec. 5 Twp. 20 R. 10W.Well No. 2. PoncinTatlock

Company

Contractor

SECTION PLAT

990 Ft. from N. Line

_____ Ft. from S. Line

_____ Ft. from E. Line

990 Ft. from W. Line**FIRST REPORT**Location ✓

Rig up _____

Drilling and Remarks:

RECORD

Cased _____ in., _____ ft.

Sand _____

Gas _____

Oil _____

Total Depth _____

PRODUCTION

1st 24 hrs. Nat. _____

1st 24 hrs. after shot _____

Gas _____ Cu. Ft.

Dry Hole _____

Abandoned _____

Date

MAR 24 1937

19

S. J. LEWIS Scout

KANSAS *Rice*Map No. _____ Sec. 5 Twp. 20 R. 10W.Well No. 2 PoncinHaddock Company

Contractor _____

SECTION PLAT

990 Ft. from N. Line

_____ Ft. from S. Line

_____ Ft. from E. Line

330 Ft. from W. Line**CORRECTION**

Location _____

Rig up _____

Drilling and Remarks:

Reported
BENNE
should be
BONNE

RECORD

Cased _____ in., _____ ft.

Sand _____

Gas _____

Oil _____

Total Depth _____

PRODUCTION

1st 24 hrs. Nat. _____

1st 24 hrs. after shot _____

Gas _____ Cu. Ft.

Dry Hole _____

Abandoned _____

Date

MAR 31 1937 19S. J. LEWIS Scout

Rice KANSAS

Map No. _____ Sec. 5 Twp. 20 R. 10^WWell No. 2-PoncinJ. H. Tatlock Company

Contractor

COMPLETED990 Ft. from N. Line

_____ Ft. from S. Line

_____ Ft. from E. Line

330 Ft. from W. Line**SECTION PLAT**

		0	

Location _____

Rig up _____

Drilling and Remarks:

Pumped 271 oil-3 hrs(Refuses To Take 24-hr Tests)**RECORD**

Cased _____ in., _____ ft.

Sand 511-3293½

Gas _____

Oil _____

Total Depth 3299**PRODUCTION**

1st 24 hrs. Nat. _____

1st 24 hrs. after shot _____

Gas _____ Cu. Ft.

Dry Hole _____

Abandoned _____

Date

APR 28 1937

19

H. D. Hatfield Scout