


Section 5 Township 20 Range 10-W

Well Number 2 - Poncin

Company Gulf

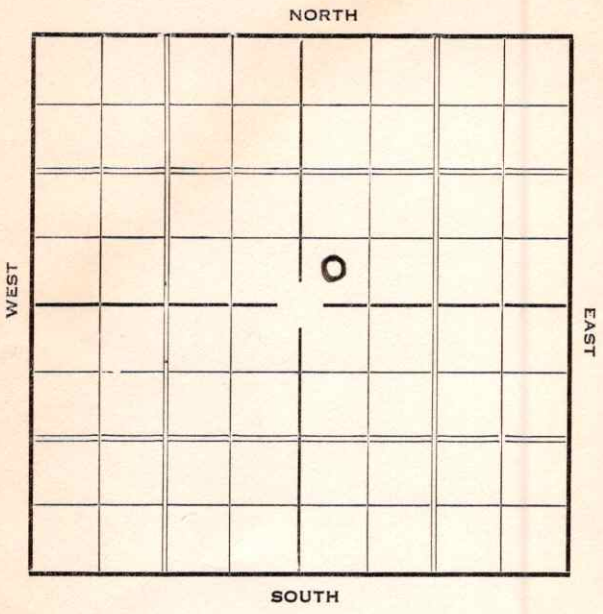

Sec. 5 Twp. 20 R. 10-W

Well No. #2 Poncin Farm

Gulf Company


         Ft. from N. Line

330 Ft. from S. Line

         Ft. from E. Line

330 Ft. from W. Line

**Elev. 1809**

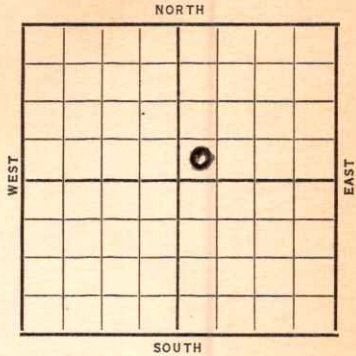

Date

REPORT

1937

5/19 R. R.

5/28 10" @ 166'. Drlg. 1882'.

6/4 **Sil. 3328-31'** T.D.

7" @ 3328'. RUST.

6/11 T.D. 3336'. Swaba 352 oil 6

hrs. Nat. 2000 A

6/16 7" @ 3328'.

**Sil. 3328'.**

T.D. 3336'.

2000 A

Pump 371 bbls. 6 hrs.

Pot. 1336 bbls.

**COMPLETED**

Rice **KANSAS**Map No. 46 Sec. 5 Twp. 20 R. 10<sup>w</sup>Well No. 2-PoncinGulf Company

Contractor

## FIRST REPORT

## SECTION PLAT

		0	

\_\_\_\_\_ Ft. from N. Line

330 Ft. from S. Line

\_\_\_\_\_ Ft. from E. Line

330 Ft. from W. Line

Location \_\_\_\_\_

Rig up \_\_\_\_\_

Drilling and Remarks:

R. R.

## RECORD

Cased \_\_\_\_\_ in., \_\_\_\_\_ ft.

Sand \_\_\_\_\_

Gas \_\_\_\_\_

Oil \_\_\_\_\_

Total Depth \_\_\_\_\_

## PRODUCTION

1st 24 hrs. Nat. \_\_\_\_\_

1st 24 hrs. after shot \_\_\_\_\_

Gas \_\_\_\_\_ Cu. Ft.

Dry Hole \_\_\_\_\_

Abandoned \_\_\_\_\_

Date

MAY 19 1937

19

H. D. Hatfield Scout

Map No. 46 Sec. 5 Twp. 20 R. 10 <sup>W</sup>Well No. 2-PoncinGulf Company

Contractor

## COMPLETED

       Ft. from N. Line330 Ft. from S. Line       Ft. from E. Line330 Ft. from W. Line

## SECTION PLAT

		0	

Location       Rig up       

Drilling and Remarks:

2000 APump 37 1/6Pat 1336

## RECORD

Cased 7 in., 3328 ft.Sand 511 3328Gas       Oil       Total Depth 3336

## PRODUCTION

1st 24 hrs. Nat.       1st 24 hrs. after shot       Gas        Cu. Ft.Dry Hole       Abandoned       

Date

JUN 16 1937

19

H. D. Hatfield Scout