


Map No. 14 Sec. 22 Twp. 27 R. 7

Well No. 3 Fobler Farm

O. H. Boyle et al Company

NORTH

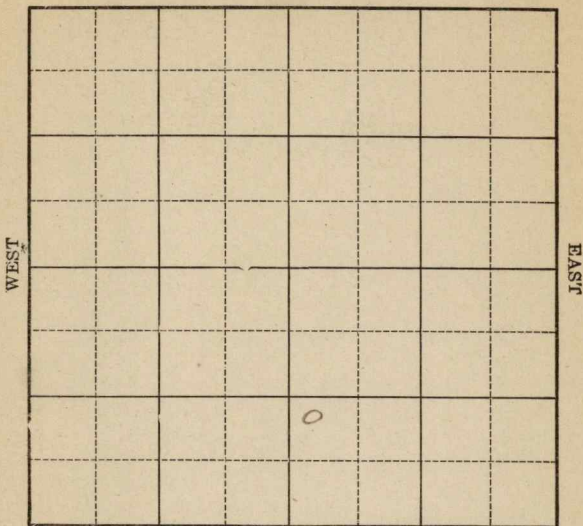

SOUTH

Location _____

Drilling Remarks

Rig Up-----

Drilling Remarks

RECORD

Cased _____ in. _____ ft.

Sand

Gas

Oil

Total Depth -----

PRODUCTION

1st 24 hrs. Nat.

1st 24 hrs. after shot -----


Gas-----cu. ft.

Dry Hole

Abandoned

Map No. Kansas Sec. 22 Twp. 27 R. 7Well No. 3 Fobler FarmO. A. Boyle et al Company

NORTH

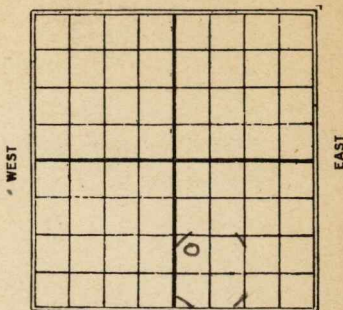

SOUTH

Ft. from N. Line

990 Ft. from S. Line

Ft. from E. Line

330 Ft. from W. Line

Date

REPORT

192512/23Location12/3119261/81/141/201/272/42/102/172/243/93/103/183/25Dlg 345'✓ - 1200✓ 1550✓ 22906" 2696 T.S. 2715 first
oil 2725' T.D. 2740, 800'
oil in hole.I.P. 2748 Shot 50 qts
swab 220 bbls. 1st 19 hrsSand 2715-274850 qts 220 bbls

Bother Co

Map No. KANSAS 10 22 Sec. 27 Twp. 27 R. 7Well No. 3 totherO. G. Doyle et al Company

Contractor

SECTION PLAT

Ft. from N. Line

990 Ft. from S. Line

Ft. from E. Line

330 Ft. from W. Line

FIRST REPORTS

Location ✓

Rig up

Drilling and Remarks:

RECORD

Cased _____ in., _____ ft.

Sand _____

Gas _____

Oil _____

Total Depth _____

PRODUCTION

1st 24 hrs. Nat. _____

1st 24 hrs. after shot _____

Gas _____ Cu. Ft.

Dry Hole _____

Abandoned _____

Date

DEC 23 1925

CHAS. L. SHERWOOD

192

Scout

K10 KANSAS 22 Twp. 27 R. 7
 Map No. Sec. Twp. R.
 Well No. 3 To bln
 O. W. Boyb et al Company
 Contractor

COMPLETED

SECTION PLAT

Ft. from N. Line

990 Ft. from S. Line

Ft. from E. Line

230 Ft. from W. Line

		0	

Location

Rig up

Drilling and Remarks:

1st oil 27 25

501 220 lbs.

RECORD

Cased in. ft.

Sand 2715-2748

Gas

Oil

Total Depth 2748

PRODUCTION

1st 24 hrs. Nat.

1st 24 hrs. after shot

Gas Cu. Ft.

Dry Hole

Abandoned

Date

MAR 25 1926

192

CHAS. L. SHERWOOD

Scout