


Map No. _____ Sec 4 Twp. 30 R. 12

Well No. Freeman Farm _____
Jarowicz & Ugle Company

COMPLETED

NORTH

WEST

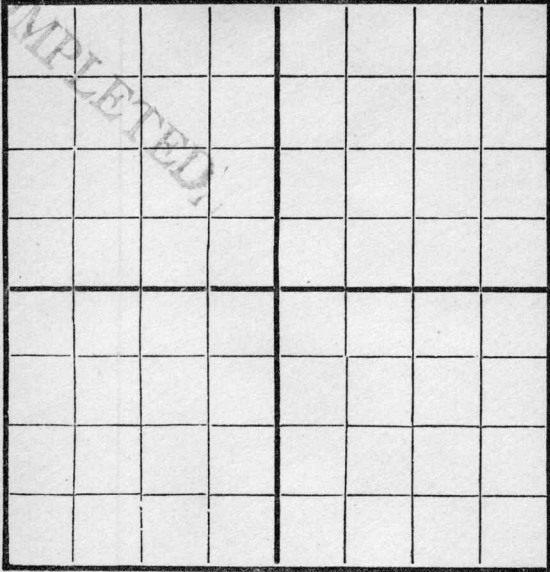

EAST

SOUTH

Location _____

Rig Up _____

Drilling Remarks:

Drilling Remarks:

Plugged at 1130

RECORD

PRODUCTION

Cased _____ in _____ Ft.

1st 24 hrs. Nat. _____

Sand _____

1st 24 hrs. after shot _____

Gas _____

Gas _____ Cu. Ft.

Oil _____

Dry Hole _____

Total Depth _____

Abandoned _____

Map No. _____ Sec. 4 Twp. 30 R 17

Well No. 1- Freeman Far _____

Freeman & Logan Compan. _____

NORTH

WEST

EAST

SOUTH

Location ?

Rig Up _____

Drilling and remarks

Blugged at
1135 ft

RECORD

Cased _____ in. _____ Ft.

Sand _____

Gas _____

Oil _____

Total Depth _____

PRODUCTION

1st 24 hrs. Nat. _____

1st 24 hrs. after shot _____

Gas _____ Cu. Ft.

Dry Hole _____

Abandoned _____

Date

5730, 191 6. LLC Scout