


Map No. Kansas Sec. 22 Twp. 27 R. 7
 Well No. 1 Trusdale Farm
Phillips Pet Company

NORTH

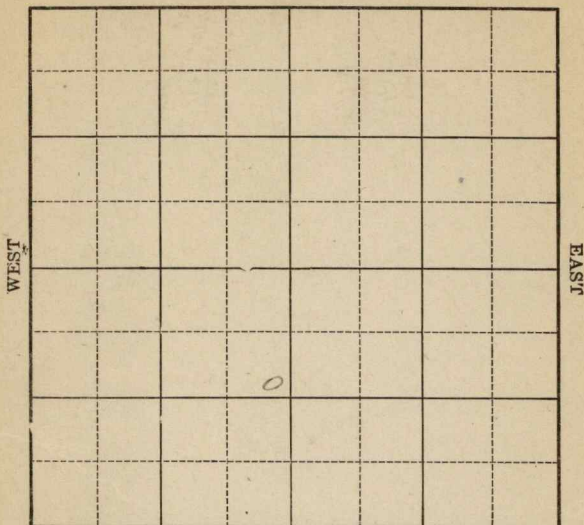

SOUTH

Location _____

Drilling Remarks _____

Rig Up _____

Drilling Remarks _____

RECORD

Cased _____ in. _____ ft.

Sand _____

Gas _____

Oil _____

Total Depth _____

PRODUCTION

1st 24 hrs. Nat. _____

1st 24 hrs. after shot _____

Gas _____ cu. ft.


Dry Hole _____

Abandoned _____

Butler Co

Map No. Kansas Sec. 22 Twp. 27 R. 7Well No. 1 Truesdale FarmPhillips Pet Company

NORTH

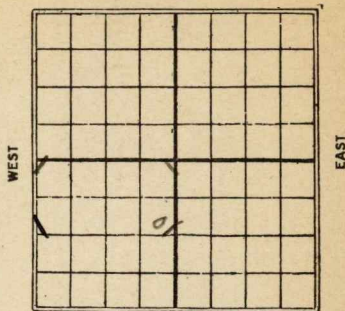990 Ft. from N. Line

Ft. from S. Line

330 Ft. from E. Line

Ft. from W. Line

SOUTH

Date

REPORT

~~1925~~
 12/23 Location
 12/31 Rig
1926
 1/8 Rigging up.
 1/14 Spudding
 1/20 Drily 600
 1/27 Drily 600
 2/4 - ✓ 1550
 2/10 ✓ 1640
 2/17 ✓ 2055
 3/2 Abandoned 2778

Butler Co

Map No. KANSAS ^{10 22} Sec. 22 Twp. 27 R. 7Well No. 1 MeadabPhillips pet Co Company

Contractor

SECTION PLAT

/		/	
/		o	/

990 Ft. from N. Line

Ft. from S. Line

330 Ft. from E. Line

Ft. from W. Line

FIRST REPORTS

Location ✓

Rig up

Drilling and Remarks:

RECORD

Cased _____ in., _____ ft.

Sand _____

Gas _____

Oil _____

Total Depth _____

PRODUCTION

1st 24 hrs. Nat. _____

1st 24 hrs. after shot _____

Gas _____ Cu. Ft.

Dry Hole _____

Abandoned _____

Date

DEC 23 1925

192

CHAS. L. SHERWOOD

Scout

Butter Co
 K10 KANSAS Sec. 22 Twp. 27 R. 7
 Map No. 1 Lucas Sub
 Well No. Phillips Pet Co
 Company

Contractor

COMPLETED

SECTION PLAT


990 Ft. from N. Line

Ft. from S. Line

330 Ft. from E. Line

Ft. from W. Line

ABANDONED

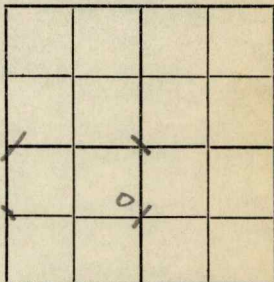

Location

Rig up

Drilling and Remarks:

Ady shab 2650-63'

Tap line 2765'

Dry 2 hrs

20 2778'

RECORD

Cased _____ in., _____ ft.

Sand _____

Gas _____

Oil _____

Total Depth 2778'

PRODUCTION

1st 24 hrs. Nat. _____

1st 24 hrs. after shot _____

Gas _____ Cu. Ft.

Dry Hole ✓

Abandoned ✓

Date

MAR 3 1926

192

CHAS. L. SHERWOOD

Scout