

Map No. **KANSAS** Sec. 22 Twp. 27 R. 7

Well No. 2 Treesdale Farm
Texas Company

NORTH

WEST

EAST

SOUTH

Location _____

Drilling Remarks

Rig Up-----

Drilling Remarks

RECORD

Cased _____ in. _____ ft.

Sand

Gas

Oil

Total Depth _____

PRODUCTION

1st 24 hrs. Nat.-----

1st 24 hrs. after shot -----

Gas _____ cu. ft.

Dry Hole_____


Abandoned -----

Map No. Kansas Sec. 22 Twp. 27 R. 7Well No. 2 J mesdale Farm
Texas Co Company

Ft. from N. Line

990 Ft. from S. Line330 Ft. from E. Line

Ft. from W. Line

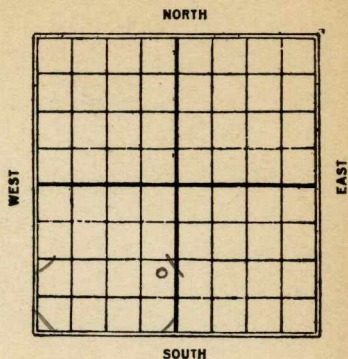Date 1/25

REPORT

1/31 Timber19241/8 Bldg rig1/4 Rig50 Spudding1/27 _____2/4 Dlg 1800'3/10 S.D. 2065'2/23 Broken sand 2687-91S.D. 2740 Dry (Tel)2/24 S. & G. 2745

10 Map No. KANSAS Sec. 22 Twp. 27 R. 7

Well No. 2 Trusdale
Lexa Co Company

Contractor

SECTION PLAT


_____ Ft. from N. Line

990 Ft. from S. Line

330 Ft. from E. Line

_____ Ft. from W. Line

FIRST REPORTS

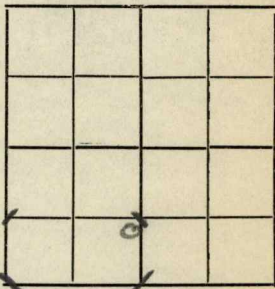

Location Timbers

Rig up _____

Drilling and Remarks:

RECORD

Cased _____ in., _____ ft.

Sand _____

Gas _____

Oil _____

Total Depth _____

PRODUCTION

1st 24 hrs. Nat. _____

1st 24 hrs. after shot _____

Gas _____ Cu. Ft.

Dry Hole _____

Abandoned _____

Date

DEC 31 1925

CHAS. L. SHERWOOD

192

Scout

1115 KANSAS 22 27 7
 Map No. Sec. Twp. R.
 Well No. 2 *Trinidad*
Texaco Company Company

Contractor

COMPLETED

SECTION PLAT

Ft. from N. Line

990


Ft. from S. Line

250

Ft. from E. Line

Ft. from W. Line

ABANDONED

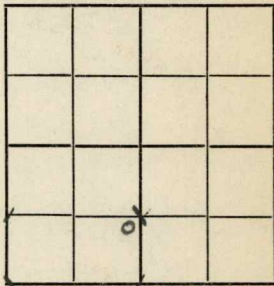

Location

Rig up

Drilling and Remarks:

dry & khd

2 1 2745

no show

RECORD

Cased in. ft.

Sandy shot 2687-91'

Gas

Oil

Total Depth 2745'

PRODUCTION

1st 24 hrs. Nat.

1st 24 hrs. after shot

Gas Cu. Ft.

Dry Hole

Abandoned

Date

FEB 24 1926

CHAS. L. SHERWOOD

192

Score