


Elk

Section 29 Township 30 Range 12-E

Well No. 1 - Cook

Company Morgan et al

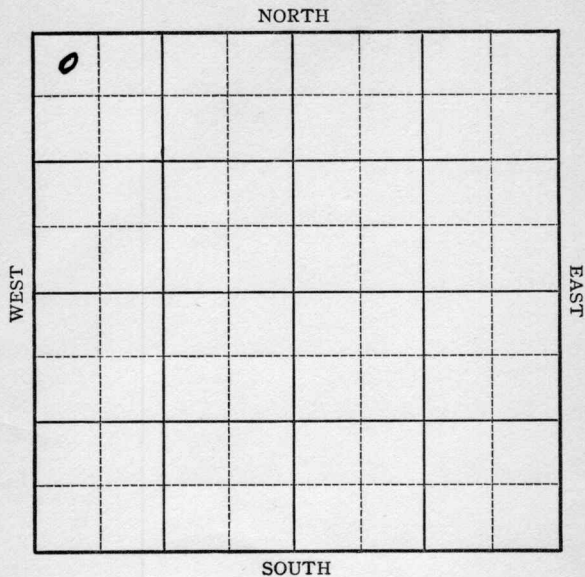

Sec. 29 Twp. 30 R. 12-E

Well No. #1 Cook Farm


Morgan et al Company

330 Ft. from N. Line

\_\_\_\_\_ Ft. from S. Line

\_\_\_\_\_ Ft. from E. Line

330 Ft. from W. Line

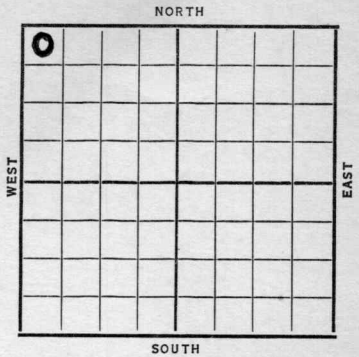

Date	REPORT
1937	
6/16	Mach.
6/25	10" @ 427'. Drlg. 563'.
7/2	" " " "
7/9	" " " "
7/16	Miss. 1628'. Drlg. 1790'.
7/23	T.D. 1790' SD.
7/28	S11 1947'
	TD 2001' HFW
	D&A
	<b>ABANDONED</b>

Map No. 9 Sec. 29 Twp. 30 R. 12<sup>E</sup>

Well No. 1-Cook

Morgan et al Company  
Contractor

FIRST REPORT

SECTION PLAT

330 Ft. from N. Line

\_\_\_\_\_ Ft. from S. Line

\_\_\_\_\_ Ft. from E. Line

330 Ft. from W. Line

0			

Location \_\_\_\_\_

Rig up \_\_\_\_\_

Drilling and Remarks:

mach

RECORD

Cased \_\_\_\_\_ in., \_\_\_\_\_ ft.

Sand \_\_\_\_\_

Gas \_\_\_\_\_

Oil \_\_\_\_\_

Total Depth \_\_\_\_\_

PRODUCTION

1st 24 hrs. Nat. \_\_\_\_\_

1st 24 hrs. after shot \_\_\_\_\_

Gas \_\_\_\_\_ Cu. Ft.

Dry Hole \_\_\_\_\_

Abandoned \_\_\_\_\_

Date

JUN 16 1937 19

H. D. Hatfield Scout

*Elk*

KANSAS

Map No. 9 Sec. 29 Twp. 30 R. 12E

Well No. 1-Cook

Morgan et al Company

Contractor

ABANDONED

SECTION PLAT

0			

330 Ft. from N. Line

\_\_\_\_\_ Ft. from S. Line

\_\_\_\_\_ Ft. from E. Line

330 Ft. from W. Line

Location \_\_\_\_\_

Rig up \_\_\_\_\_

Drilling and Remarks:

*HFW*

*DVA*

RECORD

Cased \_\_\_\_\_ in., \_\_\_\_\_ ft.

~~Sand~~ *511 1947*

Gas \_\_\_\_\_

Oil \_\_\_\_\_

Total Depth 2001

PRODUCTION

1st 24 hrs. Nat. \_\_\_\_\_

1st 24 hrs. after shot \_\_\_\_\_

Gas \_\_\_\_\_ Cu. Ft.

Dry Hole \_\_\_\_\_

Abandoned \_\_\_\_\_

Date

JUL 28 1937<sup>19</sup>

H. D. Hatfield Scout