


Map No. _____ Sec 29 Twp. 30 R. 12

Well No. 1 & J Dunlop Farm _____
Alto Oil Co Company _____

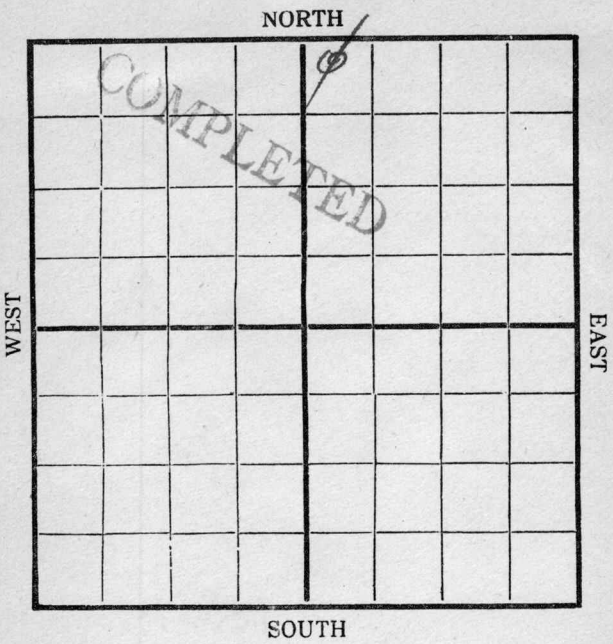

Location _____

Rig Up _____

Drilling Remarks:

520 abandoned at 1776

Drilling Remarks:

RECORD

Cased _____ in _____ Ft.
 Sand _____
 Gas _____
 Oil _____
 Total Depth _____


PRODUCTION

1st 24 hrs. Nat. _____
 1st 24 hrs. after shot _____
 Gas _____ Cu. Ft.
 Dry Hole _____
 Abandoned _____

Map No. _____ Sec. 29 Twp. 30 R. 12

Well No. 1 B + J Dunlop Farm
alta oil Company

NORTH

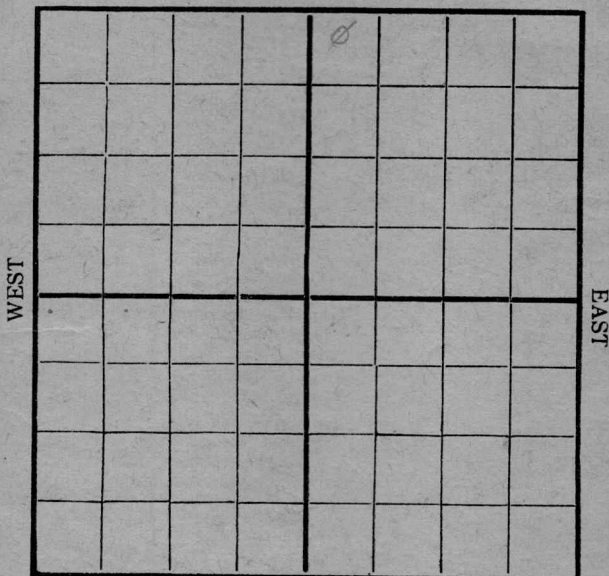

SOUTH

Location _____

Rig Up _____

Drilling and remarks

*abandoned
at 1776' ?*

RECORD

Cased _____ in. _____ Ft.

Sand _____

Gas _____

Oil _____

Total Depth _____

PRODUCTION

1st 24 hrs. Nat. _____

1st 24 hrs. after shot _____

Gas _____ Cu. Ft.

Dry Hole _____

Abandoned _____

Date

5/20, 1916 L. L. Duff Scout