


Section 21 Township 20 Range 9W

Well No. #2 Dick

Company Derby Drlg. & Sohio

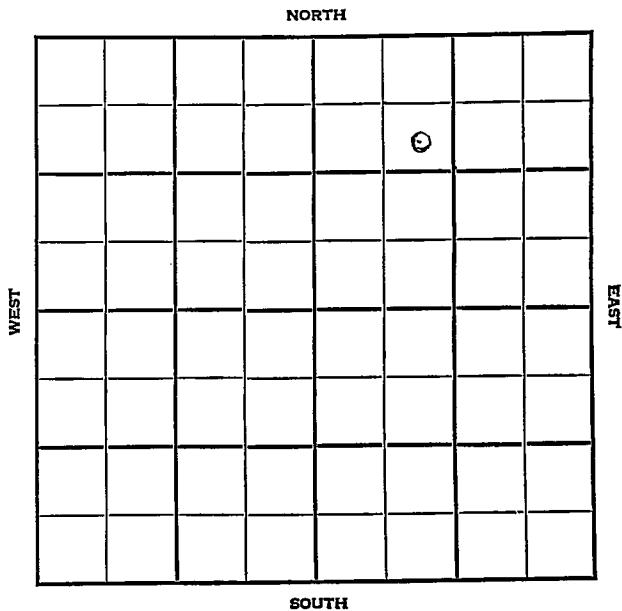

KANSAS

Rice

Sec. 21 Twp. 20 R. 9W

Well No. #2 Dick Farm

Derby Drlg. & Sohio Company

Chase Pool


990' Ft. from N. Line

_____ Ft. from S. Line

_____ Ft. from E. Line

990' Ft. from W. Line

SE NW NE

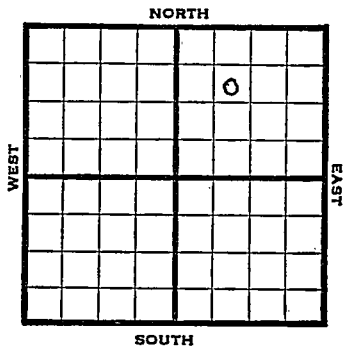

1948 Elev. 1728' REPORT

2/4 8" @ 168'
Drlg. 1655'

2/11 Arb. 3270'
TD 3313'
Abd.

ABANDONED

Map No. _____ Sec. 21 Twp. 20 R. 9W

Well No. 2 Dick

Derby Drlg. & Sohio Company

FIRST REPORT Contractor

SE NW NE

SECTION PLAT

990 Ft. from N. Line

_____ Ft. from S. Line

_____ Ft. from E. Line

990 Ft. from W. Line

Rice County

Location _____

Rig up _____

Drilling and Remarks:

8" @ 168

drlg. 1655

RECORD

Cased _____ in., _____ ft.

Sand _____

Gas _____

Oil _____

Total Depth _____

PRODUCTION

1st 24 hrs. Nat. _____

1st 24 hrs. after shot _____

Gas _____ Cu. Ft.

Dry Hole _____

Abandoned _____

Date

FEB 4 1948 19

S. J. LEWIS Scout

Map No. 49 Sec. 21 Twp. 20 R. 9W

Well No. 2 Dick

Derby Drlg. & Sohio Company

ABANDONED

Contractor

E. J. 1928.

SE NW NE

SECTION PLAT

990 Ft. from N. Line

		6'	

 Ft. from S. Line

 Ft. from E. Line

990 Ft. from W. Line

Rice County

Location

RECORD

Rig up

Cased in., ft.

Drilling and Remarks:

Sand

Gas

Oil

Total Depth 0813

Per 43270

PRODUCTION

1st 24 hrs. Nat.

1st 24 hrs. after shot

Gas Cu. Ft.

Dry Hole

Abandoned

Date

2-11-48 RLB
~~DEC 25 1947~~

S. J. LEWIS Scout