




Map No. **KANSAS** Sec. 10 Twp. 30 R. 12

Well No. 1-Willard Farm
Ward Mc Ginnis Company

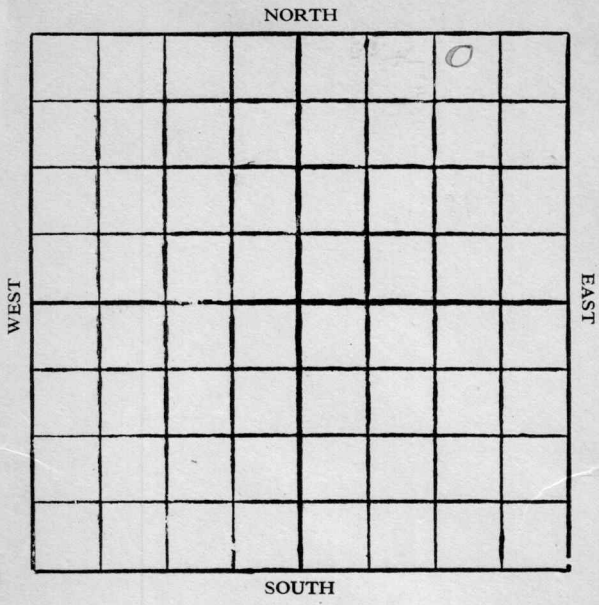

Location

Rig Up.....

Drilling Remarks

Drilling Remarks

.....

.....

RECORD

PRODUCTION

Cased..... in. ft.

Sand

Gas

Oil

Total Depth.....

1st 24 hrs. Nat.....

1st 24 hrs. after shot.....

Gas..... cu. ft.

Dry Hole.....

Abandoned.....

Map No. 9 KANSAS Sec. 10 Twp. 30 R. 12

Well No. 1 Willard
Ward Mc Sinnis Company

Contractor

FIRST REPORTS

SECTION PLAT

750 Ft. from N. Line

_____ Ft. from S. Line

1170 Ft. from E. Line

_____ Ft. from W. Line

			0

Location _____

Rig up _____

Drilling and Remarks:

Open

RECORD

Cased _____ in., _____ ft.

Sand _____

Gas _____

Oil _____

Total Depth _____

PRODUCTION

1st 24 hrs. Nat. _____

1st 24 hrs. after shot _____

Gas _____ Cu. Ft.

Dry Hole _____

Abandoned _____

Date

MAR 8 1928

CHAS. L. SHERWOOD

192

Scout

9 KANSAS

MAP NO. _____ SEC. 10 TWP. 30 R. 12

WELL NO. 1 Willard

Ward Mc Sinnis.

COMPANY

CONTRACTOR

COMPLETED

SECTION PLAT

250 FT. FROM N. LINE

_____ FT. FROM S. LINE

1170 FT. FROM E. LINE

_____ FT. FROM W. LINE

			0

ABANDONED

RECORD

LOCATION _____

CASED _____ IN. _____ FT.

RIG UP _____

SAND _____

DRILLING AND REMARKS:

GAS _____

TL 1585

OIL _____

TOTAL DEPTH 1672

PRODUCTION

Dry hole 1672

1ST 24 HRS. NAT. _____

1ST 24 HRS. AFTER SHOT _____

GAS _____ CU. FT.

DRY HOLE

ABANDONED

DATE

MAY 10 1928

CHAS. L. SHERWOOD

192

SCOUT