
DX 78-1

Sumner KANSAS

Section 14 Township 31 Range 1 E

Well No. #1 Lawless

Company J. P. Caty

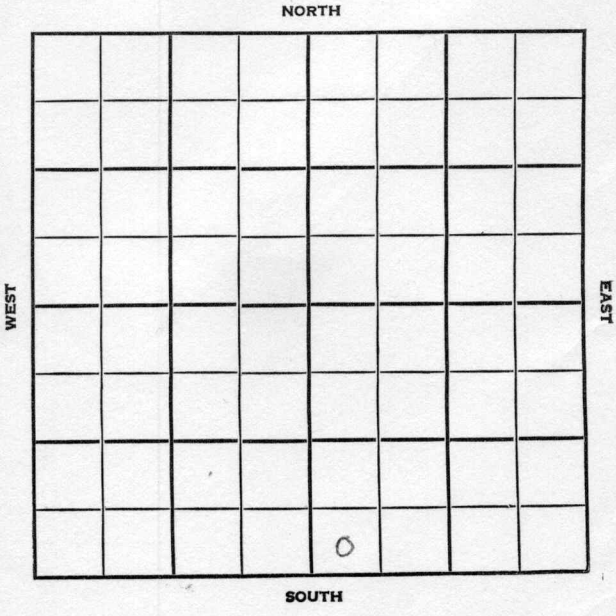

Sumner **KANSAS**

SEC.	TWP.	R.
14	31	1E

WELL NO.

#1 Lawless FARM

COMPANY

J.P. Gaty

CONTRACTOR

Mallonee


_____ Ft. from N. Line

_____ Ft. from S. Line

_____ Ft. from E. Line

_____ Ft. from W. Line

SW SW SE

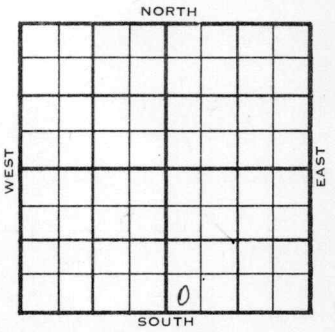

Pure - DHM

	ELEVATION 1228 REPORT
~~1956~~	
2-22	Cellar & Pits
3-14	Comm. 2-24-56 8 5/8" @ 194/225 DST 3436-42 op ½ hr. rec. 5' mud, 160# DST 3843-55 op 1½ hr. rec. 205' sw, 1385/20" D & A H. 2155 Tr. 2437 KC 2815 2814 BKC 3069 3068 Marm 3152 Ce 3238 3290 M. 3428 3437 K. 3790 Chata 3826 S. 3843 3844 A 3916 3917 TD 3945' **ABANDONED**

DX-78

FORM 513 REV. SUNRAY

County Sumner Elev.

Sec. 14 Twp. 31 Rge. 1E

Company J. P. Ga

Farm Name Lawless No. 1

TOPS	DEPTH	LOG	DATUM
Anh.			
T.p.			
H.			
Tr.			
Dg.			
B.L.			
L.			
K.C.			
B.K.C.			
Ce.			
C.			
M.			
M.			
K.			
Mz.			
Mq.			
V.			
S.			
S.			
A			
R.			
P€.			
G.			
T.D.			

Loc. in Sec. SW SW SE

Geol.

Contr. Mallonee

Pool



Date Comm.

Pure - DHM

Cellar & pits

Co. Lse. No. Sec. T. R.

FORM 513 REV. SUNRAY

County Sumner Elev. 1228

Sec. 14 Twp. 31 Rge. 1E

Company J. P. Gaty

Farm Name Lawless No. 1

TOPS	DEPTH	LOG	DATUM
Anh.			
Tp.			
H.	3155		927
Tr. Stal	2437		1209
Dg.			
Bl.			
L.			
K.C.	3815	3814	1586
B.K.C.	3069	3068	1840
Ce. Marm	3156		1924
C. e	3238	3290	2062
M.	3428	3437	2209
M.			
K.	3790		2562
Mz. Chats	3826		2598
Mo.			
V.			
S.	3843	3844	2616
S.			
A	3916	3917	2689
R.			
P€.			
G.			
T.D.	3945		

Loc. in Sec. SW SW SE

Geol.

Contr. Mallonee

Pool



Date Comm. 2-24-56

MAR 14 1956

8 5/8" @ 194/225 DST 3436-42 open ½ hr

rec. 5' mud 160# DST 3843-55

open 1½ hr. rec. 205' sw 1385/20"

D & A

Co. Lse. No. Sec. T. R.