

Summer

KANSAS

SECTION 3 TOWNSHIP 31 RANGE 1 E

WELL NO. #1 R. W. Kelly

COMPANY Beaumont Pet.

NORTH

						0	

WEST

EAST

SOUTH

Sumner

KANSAS

SEC. 3	TWP. 31	R. 1E
-----------	------------	----------

WELL NO. #1 R.W. Kelley FARM
COMPANY

Beaumont Pet.

CONTRACTOR
Co. Tools

WILDCAT


Ft. from N. Line

Ft. from S. Line

Ft. from E. Line

Ft. from W. Line

SW SE NE

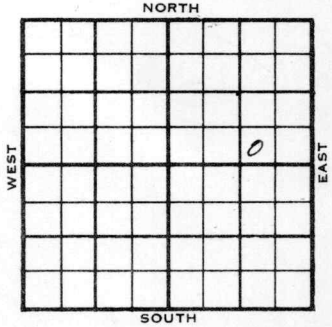

1955	ELEVATION 1202'	REPORT
------	--------------------	--------

12-21 Comm. 12-18-55
8" @ 131/100


1956

1-5 D & A
Stal. 2375
KC 2741
Pleasant 2907
Marm 3075
Ce Sh. 3248
Chert 3348
Dolo. 3357
TD 3425'

ABANDONED

County Sumner Elev. _____
 Sec. 3 Twp. 31 Rge. 1E
 Company Beaumont Pet.
 FarmName R. W. Kelley No. 1

TOPS	DEPTH	LOG	DATUM
Anh.			
Tp.			
H.			
Tr.			
Dg.			
Bl.			
L.			
K.C.			
B.K.C.			
Ce.			
C.			
M.			
M.			
K.			
Mz.			
Mq.			
V.			
S.			
S.			
A.			
R.			
Pf.			
G.			
T.D.			

Loc. in Sec. SW SE NE
 Geol. _____
 Contr. _____
 Pool Co. tools
Wildcat


Date Comm. 12-18-55
8" @ 131/100

Co.
 Lse.
 No.
 Sec.
 T.
 R.

County Sumner Elev. 1202
 Sec. 3 Twp. 31 Rge. 1E
 Company Beaumont Pet.
 Farm Name R. W. Kelley No. 1

TOPS	DEPTH	LOG	DATUM	Loc. in Sec.												
Anh.				SW SE NE												
TP.																
H. <u>Stal</u>	<u>2375</u>		<u>1173</u>													
Tr.																
Dg.																
Bl.																
L.																
K.C.	<u>2741</u>		<u>1539</u>	Geol.												
B.K.C. <u>Pleasant</u>	<u>2907</u>		<u>1706</u>	Contr.												
Ce. <u>Magma</u>	<u>3075</u>		<u>1873</u>	Co. tools												
C. <u>ls sh</u>	<u>3248</u>		<u>2046</u>													
M. <u>Chert</u>	<u>3348</u>		<u>2146</u>	Pool												
M. <u>dolo</u>	<u>3357</u>		<u>2155</u>													
K.				Wildcat												
Mz.																
Me.				<table border="1"> <tr><td></td><td></td><td></td></tr> <tr><td colspan="3" style="text-align: center;">ABANDONED</td></tr> <tr><td></td><td></td><td></td></tr> <tr><td></td><td></td><td></td></tr> </table>				ABANDONED								
ABANDONED																
V.																
S.																
S.																
A.																
R.																
PE.																
G.																
T.D.	<u>3425</u>															

Date Comm. 12-18-55 JAN 5 1956
 8" @ 131/100

D & A

Co.
Lse.
No.
Sec.
T.
R.