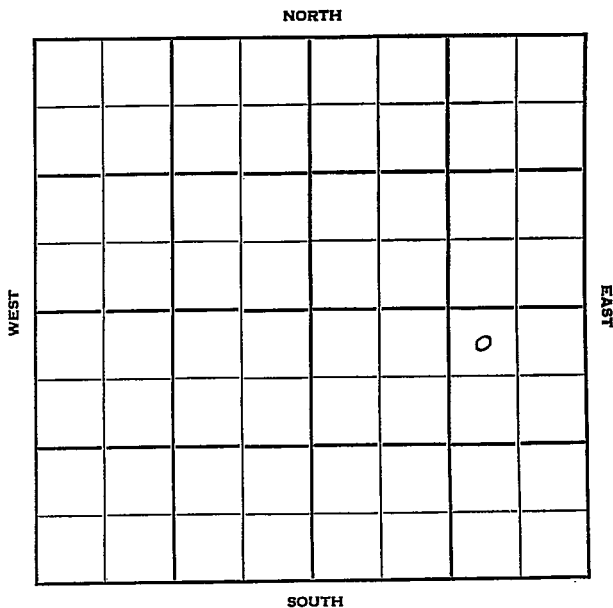


Section 1 Township 20 Range 10 WWell No. # 1 McFarlandCompany Rocket Drilling

Rice

KANSAS

Sec. 1 Twp. 20 R. 10W

Well No. #1 McFarland Farm

Rocket Drlg. Company

Contractor

Chase Pool


330' Ft. from N. Line

 Ft. from S. Line

990' Ft. from E. Line

 Ft. from W. Line

NW NE SE

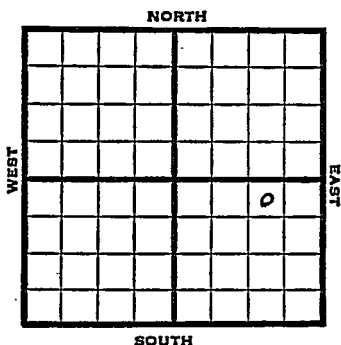

1951

Elev. 1737' REPORT


3/28

Cellar & Pits

5/23

Spud 4-4-51
Oil Well TD 3325
8" @ 151 Anhy 386
Heeb. 2804 Br Lime 2936
Lans. 2962
DST 3039-54 opn $\frac{1}{2}$ hr Rec. 30' ocm
Arb. 3288
D-T 3287-95 opn $\frac{1}{2}$ hr Rec. 500' oil
200' wtr TD 3325 5" @ 3324
CO to 3308 6/3287-89 12/3288-90
FU 1950' oil 15 hr. P/38 bopd
250 A Comp. 60 bopd 30% wtr.

COMPLETED

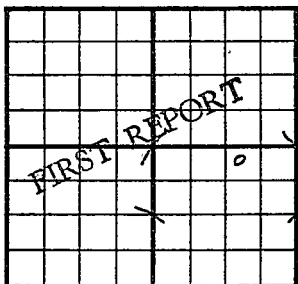County Rice State KansasSec. 1 (Blk. Twp.) 20 (Sur. Rge.) 10W Map No.Operator Rocket Drlg.Well No. 1 Farm McFarlandElev. 1737 Location NW NE SE330 Ft. From N Line SE990 Ft. From E Line Quarter1st. Report MAR 28 1951


Completion _____

Remarks _____

Spudding Date _____

Drlg. Data Chase PoolCellar & pits

J. E. TYRA

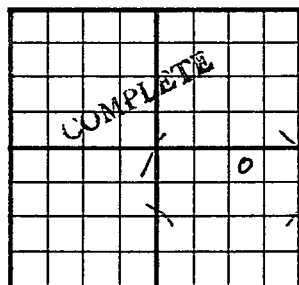County Rice State KansasSec. 1 (Blk. 20) (Sur. 10W) (Twp.) Map No.Operator Rocket Drlg.Well No. 1 Farm McFarlandElev. 1737 Location NW NE SE330 Ft. From N Line SE990 Ft. From E Line Quarter

1st. Report

Completion MAY 23 1951Remarks Chase PoolSpudding Date 4-4-51Drlg. Data Oil well TD 33258" @ 151 Anhy 386 Heeb. 2804Br. lime 2936 Lans. 2962 DST 3039-54open $\frac{1}{2}$ hr. Rec. 30' ocm Arb. 3288DST 3287-95 open $\frac{1}{2}$ hr. Rec. 500' oil200' water TD 3325 5" @ 3324EO to 3308 6/ 3287-89 12/ 3288-90FU 1950' oil 15 hr. P/ 38 bopd 250 AComp. 60 bopd 30% water

J. E. TYRA