KANSAS

FORM 51 10M 12-46 PETROL


Barton

Section 33 Township 18 Range 15-W

Well No. 3 Bird

Company Nadel & Gussman

Albert Pool

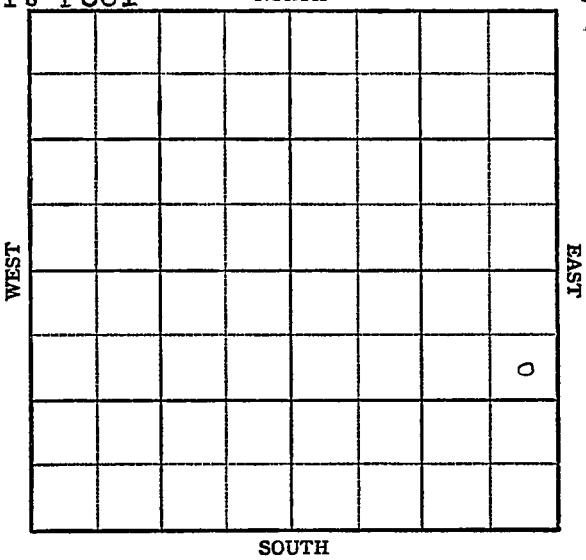

FORM 252-A
5M 9-47 PETROL

KANSAS Barton

Sec. 33 Twp. 18 R. 15W

Well No. #3 Bird Farm

Nadel & Gussman Company

Albert


990 Ft. from N. Line

Ft. from S. Line

330 Ft. from E. Line

Ft. from W. Line

SE NE SE

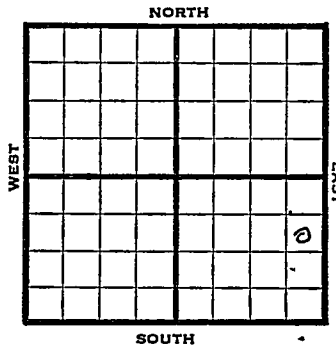

1947	Elev. 1916' REPORT
10/1	8" @ 900'
	Drlg. 2300'
10/8	Lansing 3209'
	Basal 3480'
	TD 3496'
	5" @ 3496 '
	RUST
10/15	TD 3225'
	Flow
10/22	Swb 5½ bbls oil PH, 5 hrs.
10/29	"
11/5	"
11/12	"
11/19	"
11/25	"
12/3	Basal 3480'
	5" @ 3496'
	Pump 75 Pot
	Gr. 36°
	Total Depth 3525'
	COMPLETED

Form 26 200 Bks. 10-46 Petrol

Albert Pool

Kansas

Map No. _____ Sec. 33 Twp. 18 R. 15W

Well No. 3 Bird

Nadel & Gussman Company

FIRST REPORT Contractor

SE NE SE


990 Ft. from N. Line

_____ Ft. from S. Line

330 Ft. from E. Line

_____ Ft. from W. Line

SECTION PLAT

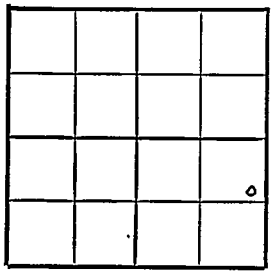

Barton County

Location _____

Rig up _____

Drilling and Remarks:

8" @ 900'

drlg. 2300

RECORD

Cased _____ in., _____ ft.

Sand _____

Gas _____

Oil _____

Total Depth _____

PRODUCTION

1st 24 hrs. Nat. _____

1st 24 hrs. after shot _____

Gas _____ Cu. Ft.

Dry Hole _____

Abandoned _____

Date

OCT 1 1947 19

S. J. LEWIS Scout

Albert Pool

Form 26 200 Bks; 10-46 Petrol

Kansas

Map No. 73 Sec. 33 Twp. 18 R. 15W

Well No. 3 Bird


Nadel & Gussman Company

COMPLETE Contractor

SE NE SE

E.1.1916

SECTION PLAT

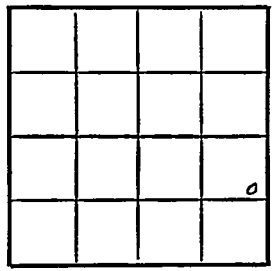

990 Ft. from N. Line

Ft. from S. Line

330 Ft. from E. Line

Ft. from W. Line

Barton County

Location

Rig up

Drilling and Remarks:

Base C 3480

5" @ 3496

Pump 75 Bbl

86 % Gy

RECORD

Cased in., ft.

Sand

Gas

Oil

Total Depth 3525'

PRODUCTION

1st 24 hrs. Nat.

1st 24 hrs. after shot

Gas Cu. Ft.

Dry Hole

Abandoned

Date

DEC 3 1947

S. J. LEWIS Scout