

Barton County


FORM 51 10M 8-47

KANSAS

Section 33 Township 18 Range 15W

Well No. 5 Bird

Company Nadel & Gussman

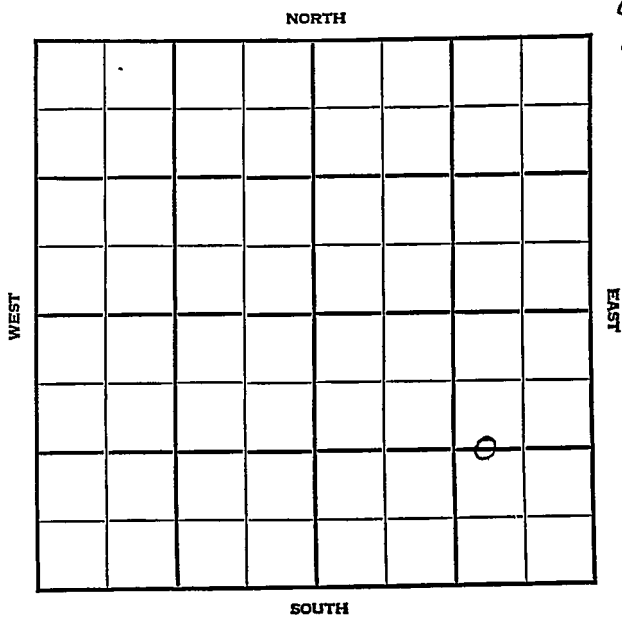

Sec. 33 Twp. 18 R. 15W

Well No. #5 Bird Farm

Nadel & Gussman Company

Albert


1320 Ft. from N. Line

_____ Ft. from S. Line

990 Ft. from E. Line

_____ Ft. from W. Line

C $W\frac{1}{2}$ E $E\frac{1}{2}$ SE

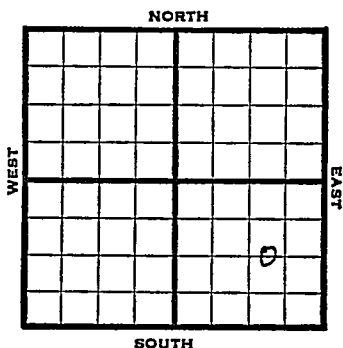

1947 Elev. 1934' REPORT

12/17 Surface hole.

12/30 8" @ 912'
Drlg. 3360'

1948
1/7 Lansing 3229'
Conglomerate 3472'
Basal 3498'
TD 3021' S. gas.
5" @ 3515'
RUST

1/14 "

1/21 "

1/26 TD 3544'
Swb. 4 bbls oil PH 8 hrs.

2/4 "

2/11 "

2/18 "

2/25 "

3/3 Basal 3498'
5" @ 3510'
Pump 50 Pot
Gr. 36°
Total Depth 3544'

COMPLETED

Map No. _____ Sec. 33 Twp. 18 R. 15W

Well No. 5 Bird

Nadel & Gussman Company

DIRECT REPORT Contractor

C $W\frac{1}{2}$ E $E\frac{1}{2}$ SE

SECTION PLAT

1320 Ft. from N. Line
_____ Ft. from S. Line
990 Ft. from E. Line
_____ Ft. from W. Line

			8

Barton County

RECORD

Location _____
Rig up _____
Drilling and Remarks:
surface hole

Cased _____ in., _____ ft.
Sand _____
Gas _____
Oil _____
Total Depth ~~1320~~ _____

PRODUCTION

1st 24 hrs. Nat. _____
1st 24 hrs. after shot _____
Gas _____ Cu. Ft.
Dry Hole _____
Abandoned _____

Date

DEC 17 1947

S. J. LEWIS

Scout

Map No. 73 Sec. 33 Twp. 18 R. 15W

Well No. 5 Bird

Nadel & Gussman Company

COMPLETE

Contractor

C $W\frac{1}{2}$ E $E\frac{1}{2}$ SE

E1, 1984
SECTION PLAT

1320 Ft. from N. Line

_____ Ft. from S. Line

990 Ft. from E. Line

_____ Ft. from W. Line

Barton County

Location _____

Rig up _____

Drilling and Remarks:

Basal 3498.
5" @ 3510.
Aug 5 0 B D

26° SW

RECORD

Cased _____ in., _____ ft.

Sand _____

Gas _____

Oil

Total Depth 2544

PRODUCTION

1st 24 hrs. Nat. _____

1st 24 hrs. after shot _____

Gas _____ Cu. Ft.

Dry Hole _____

Abandoned _____

Date

MAR 3 1948 19

S. J. LEWIS Scout