


Section 34 Township 18 Range 15-W

Well No. #6 Bird

Company Nadel & Gussman

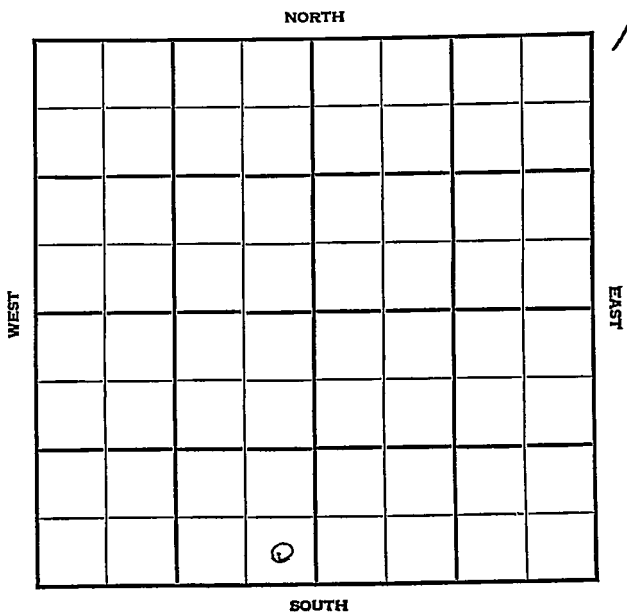



Sec. 34 Twp. 18 R. 15W

Well No. #6 Bird Farm

Nadel & Gussman Company

Albert Pool


_____ Ft. from N. Line

330' Ft. from S. Line

330' Ft. from E. Line

_____ Ft. from W. Line

SE SW

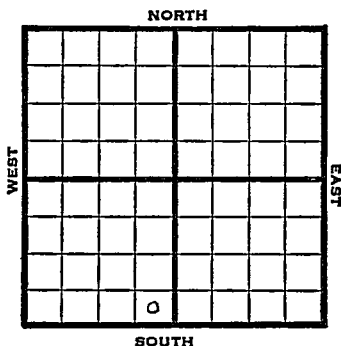

1948 Eli 1955' REPORT

- 6/30 8" @ 939'
Anhy. 925'
Drlg. 2857'
- 7/8 Reagan 3535'
TD 3552'
5" @ 3539'
- 7/14 TD 3561'
Swb 2½ oil PH
- 7/21 TD 3572'
30 qts 3550-72 CO
- 7/28 TD 3572'
swb 6 bbls oil PH
- 8/4 Reagan 3535'
5" @ 3539'
TD 3572'
30 qts 3550-72
P_ump 100 oil Pot
37° Gr.
Comp.

COMPLETED

Map No. _____ Sec. 34 Twp. 18 R. 15W

Well No. 6 Bird

Nadel & Gussman Company

FIRST REPORT Contractor

SE SW

SECTION PLAT

_____ Ft. from N. Line

330 Ft. from S. Line

330 Ft. from E. Line

_____ Ft. from W. Line

Barton County

Location _____

Rig up _____

Drilling and Remarks:

8" C 939

Anhy 925

drlg. 2857

RECORD

Cased _____ in., _____ ft.

Sand _____

Gas _____

Oil _____

Total Depth _____

PRODUCTION

1st 24 hrs. Nat. _____

1st 24 hrs. after shot _____

Gas _____ Cu. Ft.

Dry Hole _____

Abandoned _____

Date

JUN 30 1948 19

S. J. LEWIS

Scout

