

Rice

KANSAS

Section 29 Township 20 Range 9WWell No. #1 FairCompany Anschutz

NORTH

						0	

WEST

EAST

SOUTH

Rice

KANSAS ✓

Sec. 29 Twp. 20 R. 9W

Well No. #1 Fair Farm

Anschutz Company

Contractor


Ft. from N. Line

330 Ft. from S. Line

330 Ft. from E. Line

Ft. from W. Line

SW SE SE

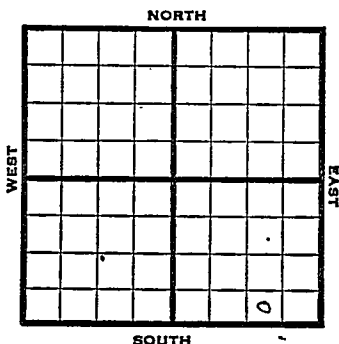

1952

Elev. 1696 REPORT

7/2

Spud 6-26-52

8" @ 256'

Drlg. 2500'

7/9

Spud 6-26-52

D&A TD 3325

8" @256

Lans. 2928

DST 2965-75 opn 1¼ hr.

Rec. 30' hgco 80#

Simp sh 3264


Simp sd 3289

Arb. 3295

TD 3325

D&A

ABANDONED

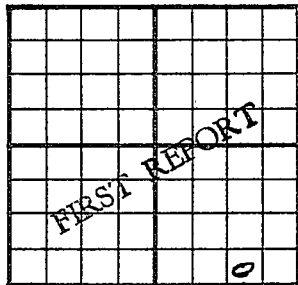County Rice State KansasSec. 29 (Blk. 1 Twp.) (Sur. 20 Rge.) 9N Map No.Operator AnschutzWell No. 1 Farm FairElev. Location SW SE SE330 Ft. From S Line SE990 Ft. From E Line Quarter1st. Report JUL 2 1952

Completion

Remarks

Spudding Date 6-26-52

Drlg. Data


8" @ 256 Drlg. 2500J. G. McGEHEE

County Rice State Kansas
 Sec. 29 (Blk.) 20 (Sur.) 9W Map No.

Operator Anschutz Drlg.

Well No. 1 Farm Fair

Elev. 1696 Location SW SE SE

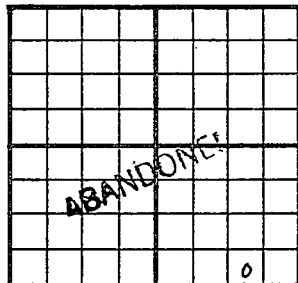

330 Ft. From S Line SE

990 Ft. From E Line Quarter

1st. Report

Completion JUL 9 1952

Remarks

Spudding Date 6-26-52

Drlg. Data D & A TD 3325

8" @ 256 Lans. 2928 DST 2965-75

open $1\frac{1}{2}$ hr. Rec. 30' hgco 80#

Simp. sh. 3264 Simp. sd. 3289

Arb. 3295 TD 3325

D & A

J. G. McGEHEE