

KANSAS


Form 51-5M-11-38-Palace

Barton

Section 33 Township 18 Range 15-W

Well No. #1 Bird

Company Aylward & Vernon

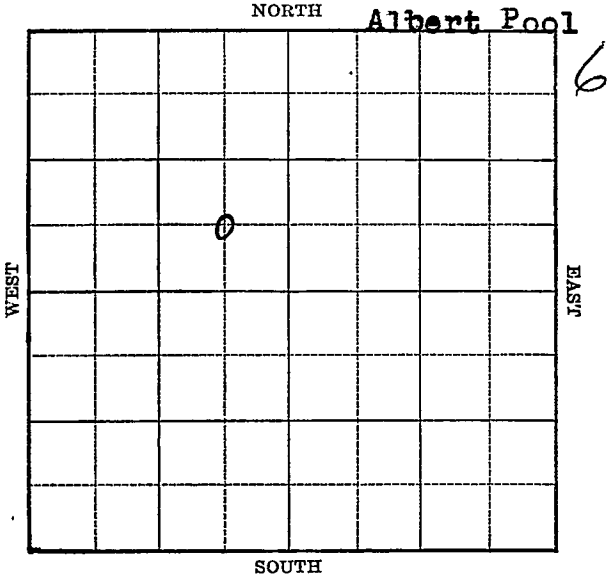

Sec. 33 Twp. 18 R. 15-W

Well No. #1 Bird Farm _____

Aylward & Vernon Company


(Albert)

_____ Ft. from N. Line

660 Ft. from S. Line

660 Ft. from E. Line

_____ Ft. from W. Line

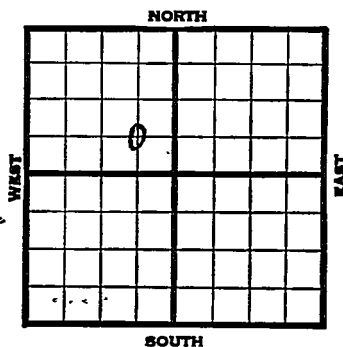

Elv. 1915

1939	REPORT
11/28	Location
12/7	Rotary.
12/14	10" - 800' Drlg.
12/21	Drlg. 1230'
12/28	Drlg. 2910'
1940	
1/4	Dodge 3145' Lans. 3200'
	B.K.C. 3425' Cherty Cong. 3455'
	Basal sand 3463' T.D. 3464'
	Runn7".
1/11	7" - 3463' RUST.
1/18	" " "
1/25	3/4 M gas 3466-69' T.D. 3474'
	No increases. Shut down.
2/1	" " " " "
2/8	SO 3499-3502' Pay 3507-09'
	T.D. 3510' Flow 37 bbls. in 24 hours. 1/2 M cu. ft. gas.
2/15	Shot 40 qts. C.O.
2/23	2 M gas. Spray 16 bbls. a day.
2/29	" " " " " "
	OVER

1940

3/8 2 M gas. Spray 16 bbls. a day.
T.D. 3510'

3/13 Reagan 3463'
7" - 3463'
T.D. 3510'
Shot 40 qts.
Flow 15 bbls.

COMPLETED

Map No. 73 Sec. 33 Twp. 18 R. 15W

Well No. 1 Bird

Aylward & Vernon

Company

Contractor

FIRST REPORT

C SE NW

_____ Ft. from N. Line

660 Ft. from S. Line

660 Ft. from E. Line

_____ Ft. from W. Line

SECTION PLAT

	o		

ALBERT POOL

Location X

Rig up _____

Drilling and Remarks:

RECORD

Cased _____ in., _____ ft.

Sand _____

Gas _____

Oil _____

Total Depth _____

PRODUCTION

1st 24 hrs. Nat. _____

1st 24 hrs. after shot _____

Gas _____ Cu. Ft.

Dry Hole _____

Abandoned _____

Date

NOV 28 1939 19

S. J. LEWIS

Scout

Map No. 73 Sec. 33 Twp. 18 R. 15WWell No. 1 BirdAylward & Vernon Company

Contractor

COMPLETED

C SE NW

 Ft. from N. Line660 Ft. from S. Line660 Ft. from E. Line Ft. from W. Line**SECTION PLAT**

	o		

ALBERT POOLLocation Rig up

Drilling and Remarks:

*Asagan 3463**2" @ 3463**Shot 409 ft.**Flow 15 8 1/2***RECORD**Cased in., ft.Sand Gas Oil Total Depth 3510**PRODUCTION**1st 24 hrs. Nat. 1st 24 hrs. after shot Gas Cu. Ft.Dry Hole Abandoned

Date

MAR 13 1940 19

S. J. LEWIS Scout