


Section 34 Township 18 Range 15-W

Well No. #8 Bird

Company Nadel & Gussman
Albert Pool

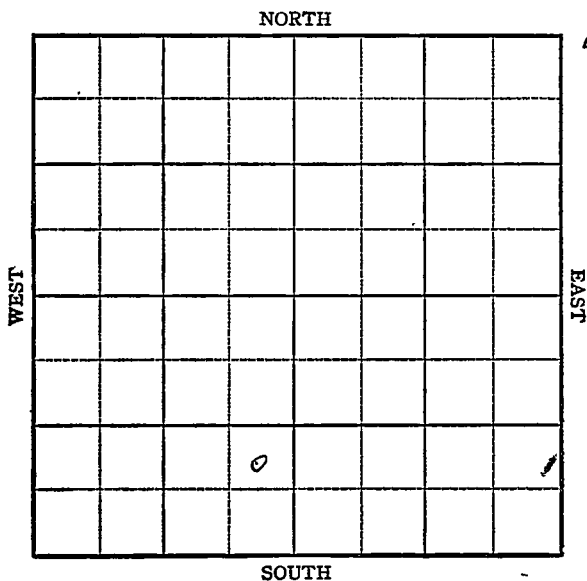

Sec. 34 Twp. 18 R. 15-W ✓

Well No. #8 Bird Farm

Nadel & Gussman Company
Albert


_____ Ft. from N. Line

990 Ft. from S. Line

330 Ft. from E. Line

_____ Ft. from W. Line

NE SE SW

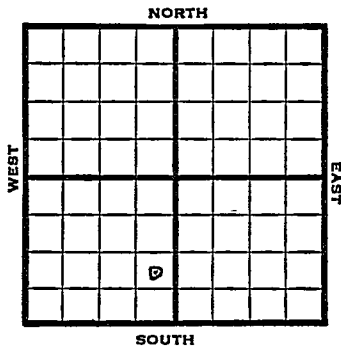

1948 Eli 1913' REPORT

10/13 RUR
10/19 8" @ 905'
Drlg 1565'
10/26 Drlg 3245'
11/3 BKC 3430'
Gorham 3482
Reagan 3501'
TD 3504
5" @ 3501'
11/10 TD 3530'
50 qts CO
11/16 "
11/23 "
12/1 TD 3530'
Reagan 3501'
5" @ 3501'
50 qts.
Pump 50 oil Pot
36° Gr.
Comp
COMPLETED

Map No. _____ Sec. 34 Twp. 18 R. 15W

Well No. 8 Bird

Nadel & Gussman Company

NE SE SW **FIRST REPORT** Contractor

SECTION PLAT

_____ Ft. from N. Line

990 Ft. from S. Line

330 Ft. from E. Line

_____ Ft. from W. Line

Barton County

RECORD

Location _____

Rig up _____

Drilling and Remarks:

R U R

Cased _____ in., _____ ft.

Sand _____

Gas _____

Oil _____

Total Depth _____

PRODUCTION

1st 24 hrs. Nat. _____

1st 24 hrs. after shot _____

Gas _____ Cu. Ft.

Dry Hole _____

Abandoned _____

Date

OCT 13 1948 19

S. J. LEWIS

Scout

Map No. 73 Sec. 34 Twp. 18 R. 15W

Well No. 8 Bird

Nadel & Gussman Company

COMPLETE

Contractor

NE SE SW

E. 1913

SECTION PLAT

_____ Ft. from N. Line

990 Ft. from S. Line

330 Ft. from E. Line

_____ Ft. from W. Line

Barton County

RECORD

Location _____

Rig up _____

Drilling and Remarks:

Reagan 5001
St. 28001
509 to
July 50 Oct 1948

369 ft

Cased _____ in., _____ ft.

Sand _____

Gas _____

Oil

Total Depth 2530

PRODUCTION

1st 24 hrs. Nat. _____

1st 24 hrs. after shot _____

Gas _____ Cu. Ft.

Dry Hole _____

Abandoned _____

Date

DEC 1 1948

S. J. LEWIS Scout