


Section 34 Township 18 Range 15W

Well No. #10 Bird

Company Nadel & Gussman

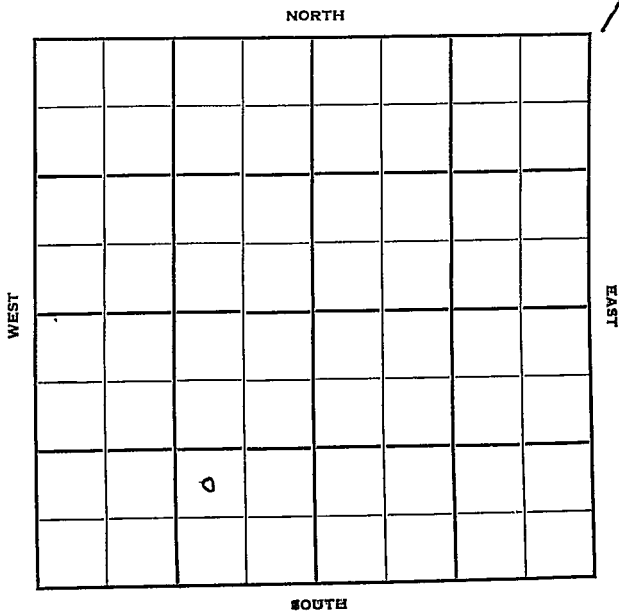

Sec. 34 Twp. 18 R. 15-W ✓

Well No. #10 Bird Farm

Nadel & Bussman Company

Reserve Drlg. Contractor

Albert


           Ft. from N. Line

990 Ft. from S. Line

990 Ft. from E. Line

           Ft. from W. Line

NW SE SW

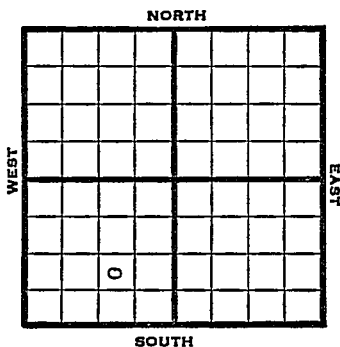

1950 Elev 1915 REPORT

9/27 Spud 9-17-50  
8" @ 904  
Anhy 895  
drlg 3135

11/8 Spud 9-17-50  
Oil Well TD 3528  
8" @ 904' Anhy 895'  
Lans. 3204' Cong. 3457' Sd 3482'  
Regan 3500'  
5" @ 3505 TD 3528'  
40 qt 3510-26  
S/20 BO 10 BWPH  
Comp. 50 BOPD 10% wtr.

COMPLETED



