


Summer

Map No. *Kans* Sec. *3* Twp. *31* R. *2 E*

Well No. *1 Griffith* Farm

Gypsy Oil Company

NORTH

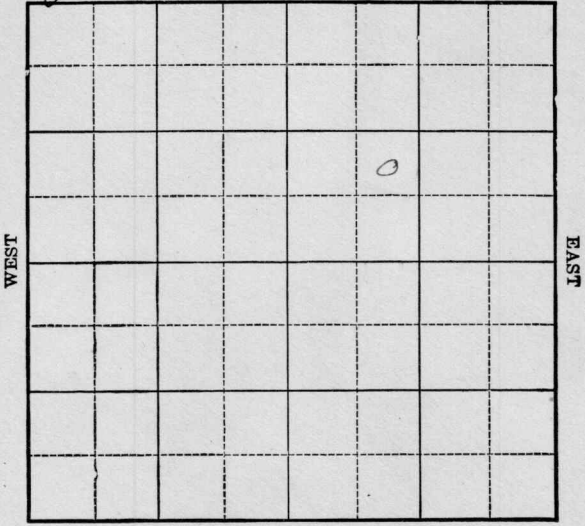

SOUTH

Location _____

Drilling Remarks

Rig Up _____

Drilling Remarks

RECORD

Cased _____ in. _____ ft.

Sand _____

Gas _____

Oil _____

Total Depth _____

PRODUCTION

1st 24 hrs. Nat. _____

1st 24 hrs. after shot _____


Gas _____ cu. ft.

Dry Hole _____

Abandoned _____

Map No. Kansas Sec. 3 Twp. 31 R. 2E
 Well No. 1 Griffith Farm
Gypsy Oil Company

Ft. from N. Line
990 Ft. from S. Line
 Ft. from E. Line
990 Ft. from W. Line

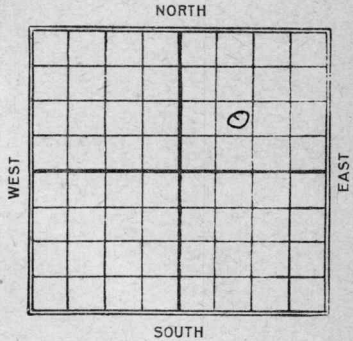

1926

Date REPORT 118/L+S

Date	REPORT
9/29	Location
10/6	same
10/13	same
10/20	same
10/27	same
11/3	R.O.G.
11/10	rig
11/17	Rigging up
11/24	Spud
12/1	Spud 120 feet
12/8	Drlg 705'
12/15	" 1215'
12/21	" 1830
12/29	" 1922
1927	
1/5	T.D. 2285 H.F. W. U.R. 10"
1/12	same
1/19	T.D. 2338 - Drlg by tools
1/26	same
2/2	_____
2/9	_____
2/16	_____

- 2/23 - T.D. 2338 - Drlg by tools
 3/2 _____
 3/9 _____
 3/16 _____
 3/23 _____
 3/30 - T.D. 2349 - fishing tools
 4/6 _____
 4/13 _____
 4/20 - Drlg 2380
 4/27 - " 2435
 5/4 - " 2660
 5/11 - T.D. 2807
 5/18 - Run 8" @ 2941 - Drlg 2941
 5/25 - Running 6" @ 3235 -
 6/1 - Drlg 3355 -
 6/8 - T.D. 3415 - u.R. 6"
 6/15 - Drlg 3430
 6/22 - S.D. 3430
 6/29 - no report -
 7/6 - Wilcox 3620 - 46 - HFW
 T.D. 3646 - S. & A.

3620
 1181

 2439

Map No. KANSAS Sec. 3 Twp. 21 R. 2E

Well No. 1 Griffith

Gypsy Oil Company

Contractor

SECTION PLAT

		o	

----- Ft. from N. Line

990 Ft. from S. Line

----- Ft. from E. Line

990 Ft. from W. Line

FIRST REPORTS

Location -----

Rig up -----

Drilling and Remarks:

Location.

RECORD

Cased ----- in., ----- ft.

Sand -----

Gas -----

Oil -----

Total Depth -----

PRODUCTION

1st 24 hrs. Nat. -----

1st 24 hrs. after shot -----

Gas ----- Cu. Ft.

Dry Hole -----

Abandoned -----

Date

SEP 29 1926
192

S. J. LEWIS

Scout

Map No. KANSAS Sec. 3 Twp. 31 R. 2A

Well No. 1 Griffith

Gypsy Oil Company

Contractor

SECTION PLAT

		0	

----- Ft. from N. Line

990 Ft. from S. Line

----- Ft. from E. Line

990 Ft. from W. Line

ABANDONED

Location -----

Rig up -----

Drilling and Remarks:

Wilcox 3620 & 46

HFW

TII 3646

I & H

RECORD

Cased ----- in., ----- ft.

Sand -----

Gas -----

Oil -----

Total Depth -----

PRODUCTION

1st 24 hrs. Nat. -----

1st 24 hrs. after shot -----

Gas ----- Cu. Ft.

Dry Hole -----

Abandoned -----

Date

JUL 6 1927

S. J. LEWIS

Scout

Summer

MAP NO. K1 KANSAS SEC. 3 TWP. 31S R. 2E

WELL NO. 1 Newell Griffith

Bygon COMPANY

CONTRACTOR

SECTION PLAT

		o	

_____ FT. FROM N. LINE

_____ FT. FROM S. LINE

_____ FT. FROM E. LINE

_____ FT. FROM W. LINE

RECORD

LOCATION _____

CASED _____ IN., _____ FT.

RIG UP _____

SAND _____

DRILLING AND REMARKS:

GAS _____

OIL _____

TOTAL DEPTH 3646

H. J. N.

we show

3646

PRODUCTION

1ST 24 HRS. NAT. _____

1ST 24 HRS. AFTER SHOT _____

GAS _____ CU. FT.

DRY HOLE

ABANDONED

DATE

7-1-3

192

SCOUT