FORM 51 10M 7-48 PETROL

KANSAS


Barton

Section 34 Township 18 Range 15W

Well No. 2 Gleissner

Company Nate Appleman

Albert Pool

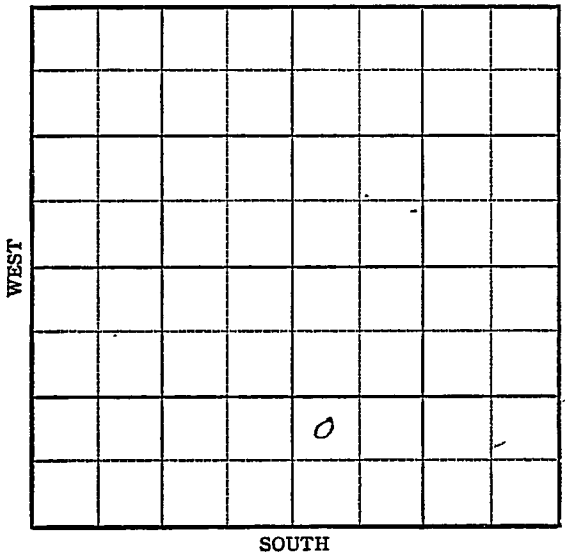

14

FORM 252-A
5M 4-48 PETROL

KANSAS Barton ✓

Sec. 34 Twp. 18 R. 15W

Well No. 2 Gleissner - Farm

Nate Appleman Company
Albert Pool


Ft. from N. Line

990 Ft. from S. Line

Ft. from E. Line

330 Ft. from W. Line

NW SW SE

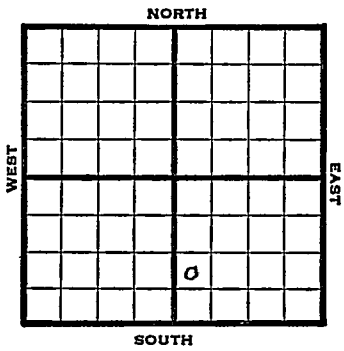

1948	Elev. 1918' REPORT
8/25	8" @ 866 WOC
9/1	Drlg. 2765'
9/8	Lansing 3207' BKC 3429 ' Gorham 3485 Reagan 3506'-26' TD 3526' 5" @ 3523'
9/14	"
9/21	TD 3533' 10 qts 3529-33' CO
9/29	Reagan 3506' 5" @ 3523' Pump 39 oil Pot. Gr. 36° TD 3533'
	COMPLETED

Form 27—100 Bks.—4-48—Petrol

Barton County Kansas State

Map No. Sec. 34 Twp. 18 R. 15W


Well No. 2 Gleissner

Nate Appleman Company

FIRST REPORT Contractor

NW SW SE

SECTION PLAT

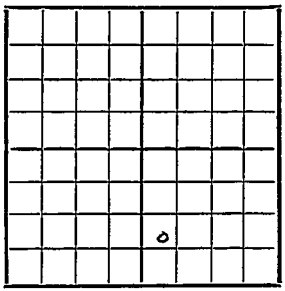

Ft. from N. Line

990 Ft. from S. Line

Ft. from E. Line

330 Ft. from W. Line

Albert Pool

Remarks:

8" @ 886 WOC

Date AUG 25 1948

Scout S. J. LEWIS

Form 26—200 Bks.—1-48—Palace

Albert Pool

Kansas

Map No. 73 Sec. 34 Twp. 18 R. 15W

Well No. 2 Gleissner


Nate Appleman Company

COMPLETE Contractor

NW SW SE

E. 1918.

SECTION PLAT

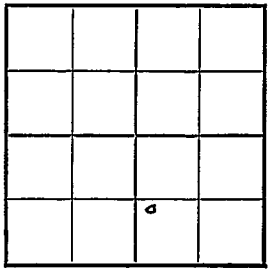

____ Ft. from N. Line

990 Ft. from S. Line

____ Ft. from E. Line

330 Ft. from W. Line

Barton County

Location

Rig up

Drilling and Remarks:

Reagan 3506

5" @ 3529

Pump 89 oil Bbls

36 gr

RECORD

Cased ____ in., ____ ft.

Sand

Gas

Oil ✓

Total Depth 3539

PRODUCTION

1st 24 hrs. Nat.

1st 24 hrs. after shot

Gas ____ Cu. Ft.

Dry Hole

Abandoned

Date

SEP 29 1948 19

S. J. LEWIS Scout