

Sumner

KANSAS

SECTION 6 TOWNSHIP 31 RANGE 2E

WELL NO. #1 Foltz

COMPANY L.C. Smitherman

NORTH

			0				

WEST

EAST

SOUTH

SEC. 6	TWP. 31	R. 2E
-----------	------------	----------

WELL NO. #1 Foltz FARM

COMPANY L.C. Smitherman

CONTRACTOR


WILDCAT

_____ FT. FROM N. LINE

_____ FT. FROM S. LINE

_____ FT. FROM E. LINE

_____ FT. FROM W. LINE

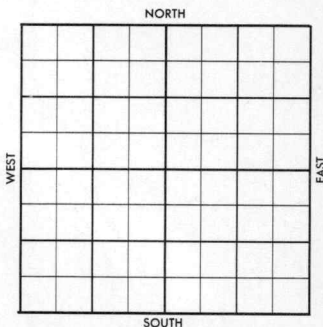

NE NE SW

Sinc., Skelly & Mag. -Support

1956	ELEVATION 1195'	REPORT
------	--------------------	--------

5-23 Set Surface

7-3

Comm. 6-16-56
 8 5/8" @ 118 w/200
 DST 3706-69 op 1 hr. rec. 470' M&SW
 FP 0-250, BHP ~~1400~~/20".
 D & A
 Stall. sd. 2374', KC. 2738', M. 3342'
 K. 3652', S.Sd, 3711',
 Log tops:
 KC. 2700', M. 3297', K. 3640',
 S.Sd. 3699', A. 3757'.
 TD 3810'

ABANDONED

County Sumner Elev. 1195
 Sec. 6 Twp. 31 Rgs. 2E
 Company L. C. Smitherman
 Farm Name Foltz No. 1

TOPS	DEPTH	LOG	DATUM	Loc. in Sec.
Anth.				NE NE SW
Tp.				
H. <u>stall sd 2374</u>				
Tr.				
Dg.				
Bl.				
L.				Geol.
K.C.	<u>2738</u>	<u>2700</u>		Contr.
B.K.C.				
Ce.				
C.				
M.	<u>3342</u>	<u>3297</u>		Pool
M.				Wildcat
K.	<u>3652</u>	<u>3640</u>		
Mz.				
Me.				
V.				
S. <u>sd</u>	<u>3711</u>	<u>3699</u>		<div style="border: 1px solid black; padding: 5px; text-align: center;"> ABANDONED JUL 1956 </div>
S.				
A.		<u>3757</u>		
R.				
PE.				
G.				
TD	<u>3810</u>	<u>3810</u>		

Date Comm. Sinc., Skelly & Mag. - support
set surface MAY 29 '56 JUN 6 '56 ✓ JUN 13 '56 ✓
 JUN 20 '56 6-16-56 85/8 118/200
\$ 400 JUN 27 '56 \$ 3509 JUL 3 '56
DST 3706-69 1hr see 470'
ME SW FP 0-250 BHP 1440/20
D & A