

# KANSAS

Barton

Section 34 Township 18 Range 15W


Well No. 3 Gleissner

Company Texas

Albert

NORTH

//

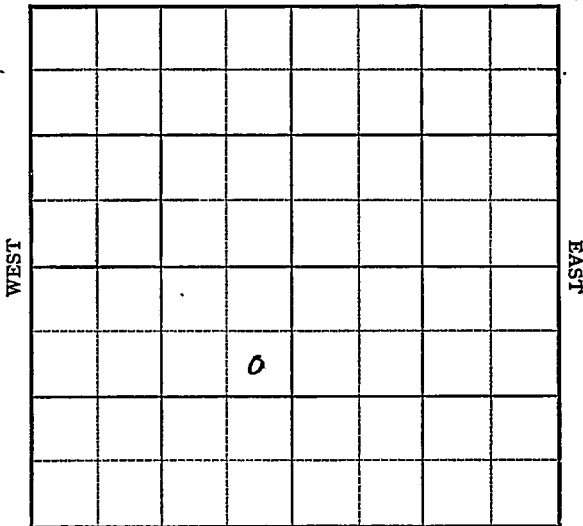

SOUTH

Sec. 34 Twp. 18 R. 15W

Well No. #3 Gleissner Farm

Texas

Company

Albert Pool


NORTH

990' Ft. from N. Line

         Ft. from S. Line

330' Ft. from E. Line

         Ft. from W. Line

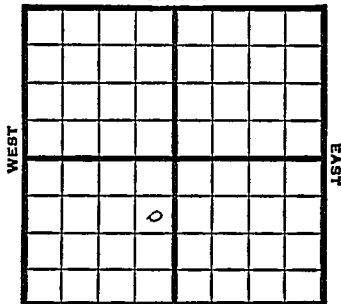

SE NE SW

SOUTH

1949

Elev. ~~1906~~ 1903' REPORT

3/9

Location

3/16

13" @ 172'

3/23

Drlg. 2720'

3/30

Lansing 3194'

Gorham 3478'

Reagan 3500'

TD 3500'

5" @ 3475'

3/4/6

Drlg 3519

1/2 M Gas SSO

4/12

TD 3520

30 qts 3509-20

CO

4/20

Flow 38 oil in 2 hrs.

4/20

TD 3520'

Reagan 3505'

5" @ 3475'

30 qts

Pump 78 Oil Pot

36° Gr.

Comp

**COMPLETED**

Kansas

Map No. \_\_\_\_\_ Sec. 34 Twp. 18 R. 15W

Well No. 3 Gleissner

Texas

Company

FIRST REPORT

Contractor

SE NE SW

SECTION PLAT

990 Ft. from N. Line

\_\_\_\_\_ Ft. from S. Line

330 Ft. from E. Line

\_\_\_\_\_ Ft. from W. Line


Barton County

Location X

Rig up \_\_\_\_\_

Drilling and Remarks:

RECORD

Cased \_\_\_\_\_ in., \_\_\_\_\_ ft.

Sand \_\_\_\_\_

Gas \_\_\_\_\_

Oil \_\_\_\_\_

Total Depth \_\_\_\_\_

PRODUCTION

1st 24 hrs. Nat. \_\_\_\_\_

1st 24 hrs. after shot \_\_\_\_\_

Gas \_\_\_\_\_ Cu. Ft.

Dry Hole \_\_\_\_\_

Abandoned \_\_\_\_\_

Date

MAR 9 1949 19

S. J. LEWIS Scout

Map No. K73 Sec. 34 Twp. 18 R. 15W

Well No. 3 Gleissner

Texas Company

**COMPLETE**

Contractor

SE NE SW

E. I. 1906

**SECTION PLAT**

990 Ft. from N. Line

\_\_\_\_\_ Ft. from S. Line

330 Ft. from E. Line

\_\_\_\_\_ Ft. from W. Line


Barton County

Location \_\_\_\_\_

Rig up \_\_\_\_\_

Drilling and Remarks:

*Log 3585*  
*5 68475*  
*309 to*  
*Prng Soil Rod*

*36 2/4*

**RECORD**

Cased \_\_\_\_\_ in., \_\_\_\_\_ ft.

Sand \_\_\_\_\_

Gas \_\_\_\_\_

Oil \_\_\_\_\_

Total Depth 3529

**PRODUCTION**

1st 24 hrs. Nat. \_\_\_\_\_

1st 24 hrs. after shot \_\_\_\_\_

Gas \_\_\_\_\_ Cu. Ft.

Dry Hole \_\_\_\_\_

Abandoned \_\_\_\_\_

Date

APR 20 1949

19

S. J. LEWIS

Scout