


Map No. KANSAS Sec. 11 Twp. 31 R. 2E

Well No. 7 - Stout Farm Washoma Oil Company

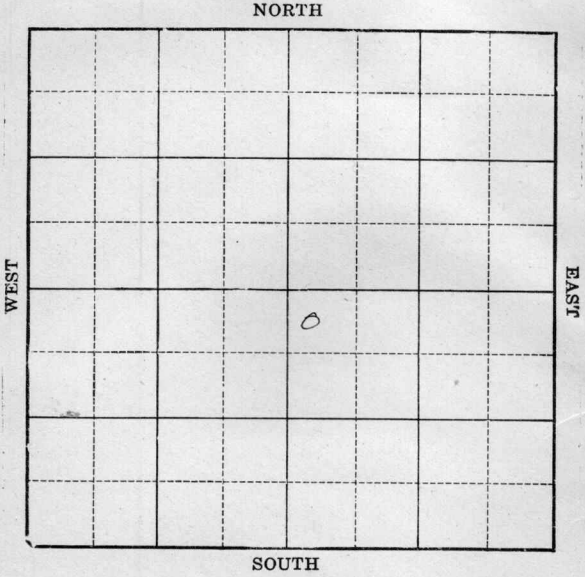

Location _____
 Drilling Remarks _____

Rig Up _____
 Drilling Remarks _____

RECORD


Cased _____ in. _____ ft.
 Sand _____
 Gas _____
 Oil _____
 Total Depth _____

PRODUCTION

1st 24 hrs. Nat. _____
 1st 24 hrs. after shot _____
 Gas _____ cu. ft.
 Dry Hole _____
 Abandoned _____

Map No. KANSAS Sec. 11 Twp. 31 R. 2^E
 Well No. 1 - Stout Farm
Nashkoma Oil Company

330 Ft. from N. Line
 _____ Ft. from S. Line
 _____ Ft. from E. Line
250 Ft. from W. Line
1930

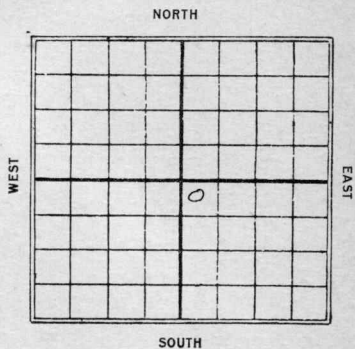

Date	REPORT
7/15	ROJ
7/23	Orig
7/30	—
8/6	—
8/13	—
8/20	Run up
8/27	—
9/3	—
9/10	—
9/17	Run up & SD
9/24	WRLY 1325'
10/11	" 1620'
10/18	" 1985'
10/15	HFW 2054-80 U/R 8"
10/22	Sand 2030-56' HFW U/R 8"-2225'
10/29	WRLY 2345'
11/5	No report
11/12	Sand 2030-56' HFW " 2265-2340 HFW TD. 2345' Abandoned

Summer

Map No. KANSAS Sec. 11 Twp. 31 R. 2 ^E

Well No. 1 *Stout*

Washoma Oil Co Company

Contractor

FIRST REPORTS

SECTION PLAT

750 Ft. from N. Line
____ Ft. from S. Line
____ Ft. from E. Line
750 Ft. from W. Line

		0	

Location *Proy*

Rig up _____

Drilling and Remarks:

RECORD

Cased _____ in., _____ ft.
Sand _____
Gas _____
Oil _____
Total Depth _____

PRODUCTION

1st 24 hrs. Nat. _____
1st 24 hrs. after shot _____
Gas _____ Cu. Ft.
Dry Hole _____
Abandoned _____

Date

JUL 16 1900

19

CHAS. L. SHERWOOD
Scout

Summer

Map No. KANSAS Sec. 11 Twp. 31 R. 2^E

Well No. 1 Stout

Washoma oil Co Company

Contractor

COMPLETE

SECTION PLAT

250 Ft. from N. Line

Ft. from S. Line

Ft. from E. Line

250 Ft. from W. Line

		o	

ABANDONED

Location

Rig up

Drilling and Remarks:

Sand 2030-56 HFW

" 2265-2340 HFW

RECORD

Cased in., ft.

Sand

Gas

Oil

Total Depth 2345

PRODUCTION

1st 24 hrs. Nat.

1st 24 hrs. after shot

Gas Cu. Ft.

Dry Hole

Abandoned

Date

NOV 12 1930

192

CHAS. L. SHERWOOD

Scout