


Section 34 Township 18 Range 15-W

Well No. #5 Gleissner

Company Texas

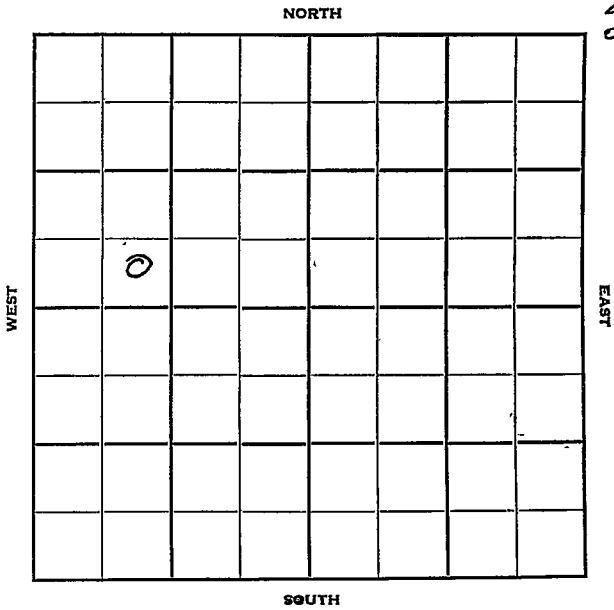

Barton

KANSAS

Sec. 34 Twp. 18 R. 15W

Well No. #5 Gleissner Farm

Texas Company

Powell & Peters - Contr. Contractor

Albert Pool


 Ft. from N. Line

330' Ft. from S. Line

 Ft. from E. Line

990' Ft. from W. Line

SE SW NW

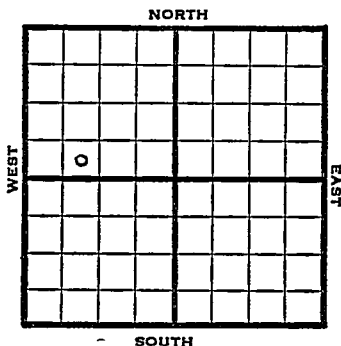

1950 Elev. 1908' REPORT

11/15 Rng Sufaace

1951

1/10

Spud 11-12-50
Oil Well TD 3520
10-3/4" @ 889' Br Lime 3189
Lans. 3198'
DST 3368-79 opn 1 hr Rec. 10' mud
7" @ 3474 Regan 3491 TD 3520
25 qt. on bottom S/19 boph S/17
bo 2 bw 7 hr Comp. 35 bo 3 bwpd

COMPLETED

