


Section 1 Township 20 Range 10-W

Well Number 1 Malone

Company Ramsey et al

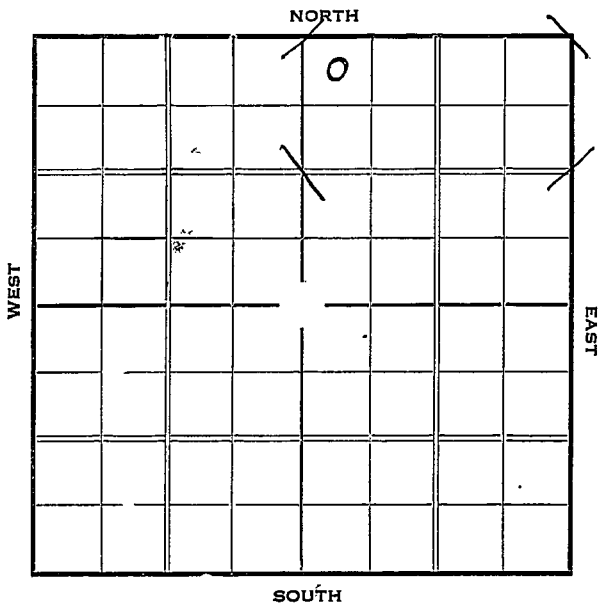

Map No. 46 Sec. 1 Twp. 20 R. 10W

Well No. 1 Malone

Ramsey & Co Company

Contractor

SECTION PLAT

		10	

320 Ft. from N. Line

_____ Ft. from S. Line

_____ Ft. from E. Line

230 Ft. from W. Line

FIRST REPORT

Location _____

Rig up _____

Drilling and Remarks:

Rig

RECORD

Cased _____ in., _____ ft.

Sand _____

Gas _____

Oil _____

Total Depth _____

PRODUCTION

1st 24 hrs. Nat. _____

1st 24 hrs. after shot _____

Gas _____ Cu. Ft.

Dry Hole _____

Abandoned _____

Date

17 1937 19

S. J. LEWIS Scout

Map No. _____ Sec. 1 Twp. 20 R. 10W

Well No. 1 Malone

Ramsey & Co Company

Contractor

SECTION PLAT

		0	

320 Ft. from N. Line

_____ Ft. from S. Line

_____ Ft. from E. Line

320 Ft. from W. Line

Location _____

Rig up _____

Drilling and Remarks:

Sil 3298
HPW

RECORD

Cased _____ in., _____ ft.

Sand _____

Gas _____

Oil _____

Total Depth 3310

PRODUCTION

1st 24 hrs. Nat. _____

1st 24 hrs. after shot _____

Gas _____ Cu. Ft.

Dry Hole

Abandoned

Date

APR 7 1937
19

S. J. LEWIS

Scout