


Map No. Kansas Sec. 27 Twp. 27 R. 7

Well No. 6-Kresse Farm _____

Amerada Company _____

NORTH

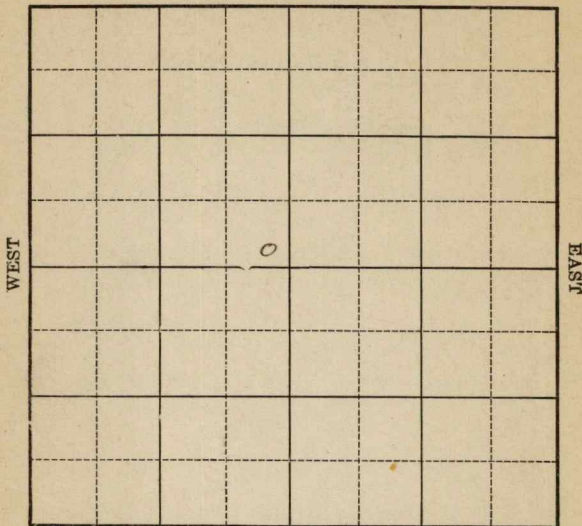

SOUTH

Location _____

Rig Up _____

Drilling Remarks _____

Drilling Remarks _____

RECORD

PRODUCTION

Cased _____ in. _____ ft.

1st 24 hrs. Nat. _____

Sand _____

1st 24 hrs. after shot _____

Gas _____

Gas _____ cu. ft.

Oil _____

Dry Hole _____

Total Depth _____

Abandoned _____

Butler

K10 KANSAS Map No. _____ Sec. *27* Twp. *27* R. *7*

Well No. *6* *Sweden* _____ Company _____

_____ Contractor _____

FIRST REPORTS

SECTION PLAT

_____ Ft. from N. Line

330

_____ Ft. from S. Line

330

_____ Ft. from E. Line

_____ Ft. from W. Line

Location _____

Timbers

Rig up _____

Drilling and Remarks:

RECORD

Cased _____ in., _____ ft.

Sand _____

Gas _____

Oil _____

Total Depth _____

PRODUCTION

1st 24 hrs. Nat. _____

1st 24 hrs. after shot _____

Gas _____ Cu. Ft.

Dry Hole _____

Abandoned _____

Date

MAR 31 1926

CHAS. L. SHERWOOD

Scout

Butter

K10 KANSAS Map No. Sec. 27 Twp. 27 R. 7

Well No. 6 Grade Kennedy Dr Co Company

Contractor

COMPLETED

SECTION PLAT

230 Ft. from N. Line
230 Ft. from S. Line
330 Ft. from E. Line
Ft. from W. Line

4x4 grid section plat with handwritten '0' in the center.

Location
Rig up
Drilling and Remarks:

bag 150 lbs.

RECORD

Cased in. ft.
Sand 2732-2758
Gas
Oil
Total Depth 2766

PRODUCTION

1st 24 hrs. Nat.
1st 24 hrs. after shot
Gas Cu. Ft.
Dry Hole
Abandoned

Date

MAY 26 1926

192

CHAS. L. SHERWOOD

Scout